




DATE MARCH 15, 1985

TOWN OF LEXINGTON — BOARD OF PUBLIC WORKS  
SEWER DIVISION

Sketch of Service Here

**135**

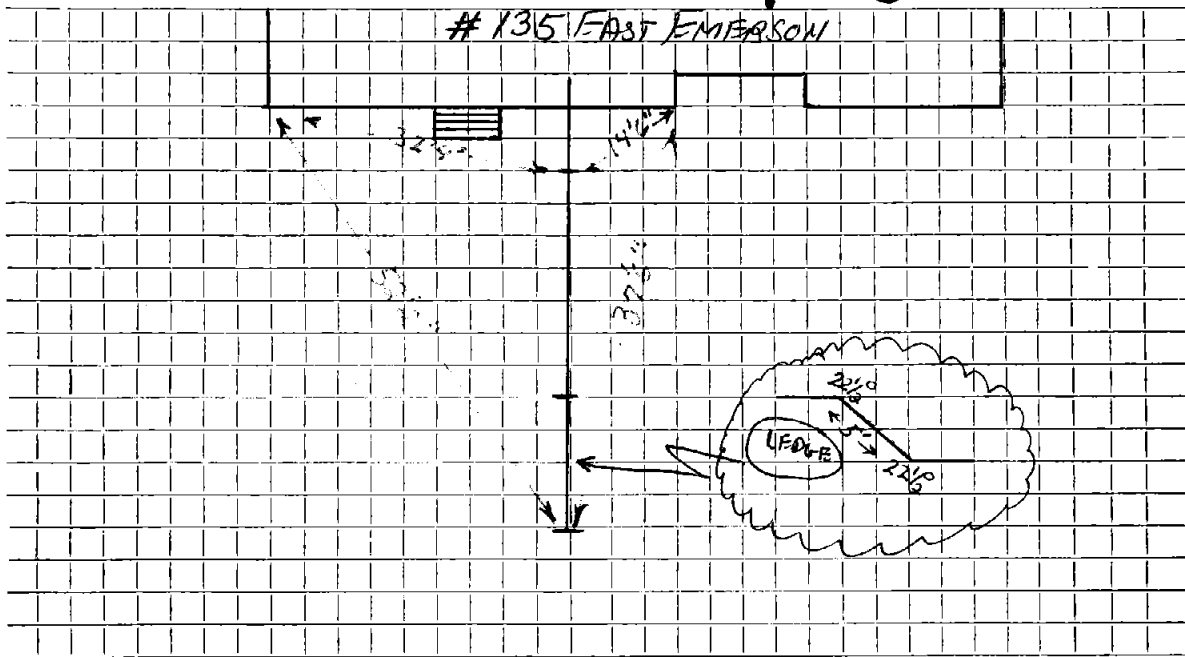

Connection made in EAST EMERSON Street.

Work completed MARCH 1985

Remarks:



- ⑤ sewer manhole
- ⑥ drain manhole

Sewer services are 6" PVC.

Lot #20 To be Tapped off easement

Sewer  
 Lots 16, 17, 18, 19, 21  
 32, 33, 34, 35, 36  
 37, 38, 39, 40, 41

Water  
 Lots 16, 17, 18, 19, 20, 21  
 32, 33, 34, 35, 36, 37, 38  
 39, 40, 41

Water services are  
 1" copper

# EAST EMERSON

1145 E. 1st St.

1145 E. 1st St.