


DATE _____

TOWN OF LEXINGTON — BOARD OF PUBLIC WORKS

SEWER DIVISION

Sketch of Service Here

136

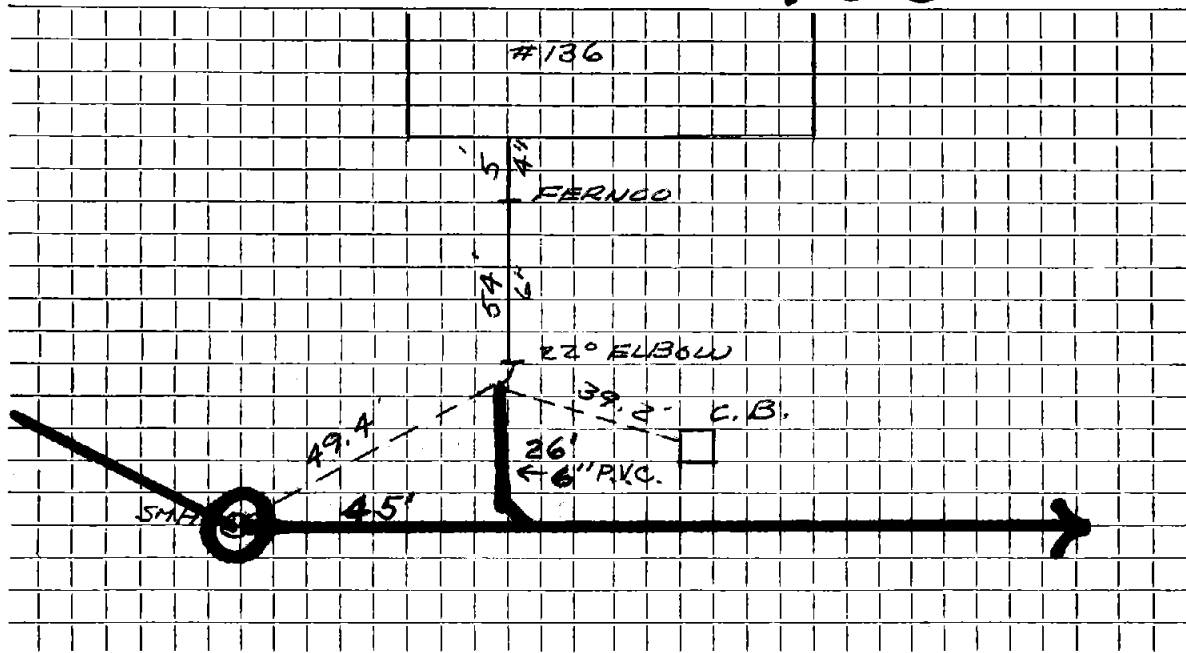

Connection made in EAST EMERSON Street. Work completed

Remarks: Subd. 10.15.10.4