


DATE _____

TOWN OF LEXINGTON — BOARD OF PUBLIC WORKS

SEWER DIVISION

Sketch of Service Here **143**

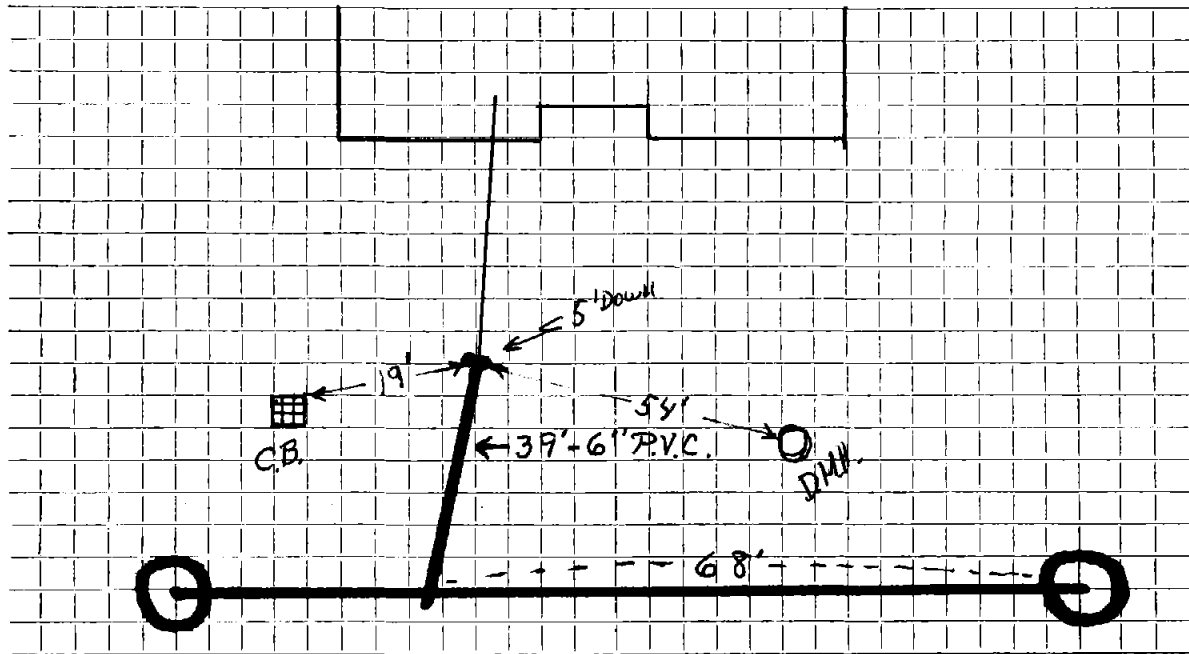

Connection made in EAST EMERSON RD Street. Work completed JULY 10, 1984

Remarks:

.....

.....