

Name

Service No.

Address 144 East Emerson Rd

Location

Lot 33

Kind of Pipe PVC

Size

6"

Size of Main 8"

Repair—Renewal—(New Service)

Location

Date

Material

Amount

Total

Date

Amount

11/1/84

~~① wye ext~~

~~① 22° bend~~

~~26 ft. 6" PVC~~

① cap.

11-1-84

26' 6" P.V.C.

1 6"-22° Bend

1 8" X 6" Wye

12/19/88

① 22° bend

① ferruce. 6" X 4"

31 ft. 6" PVC

6 ft. 4" C.I


DATE _____

TOWN OF LEXINGTON — BOARD OF PUBLIC WORKS

SEWER DIVISION

Sketch of Service Here

144

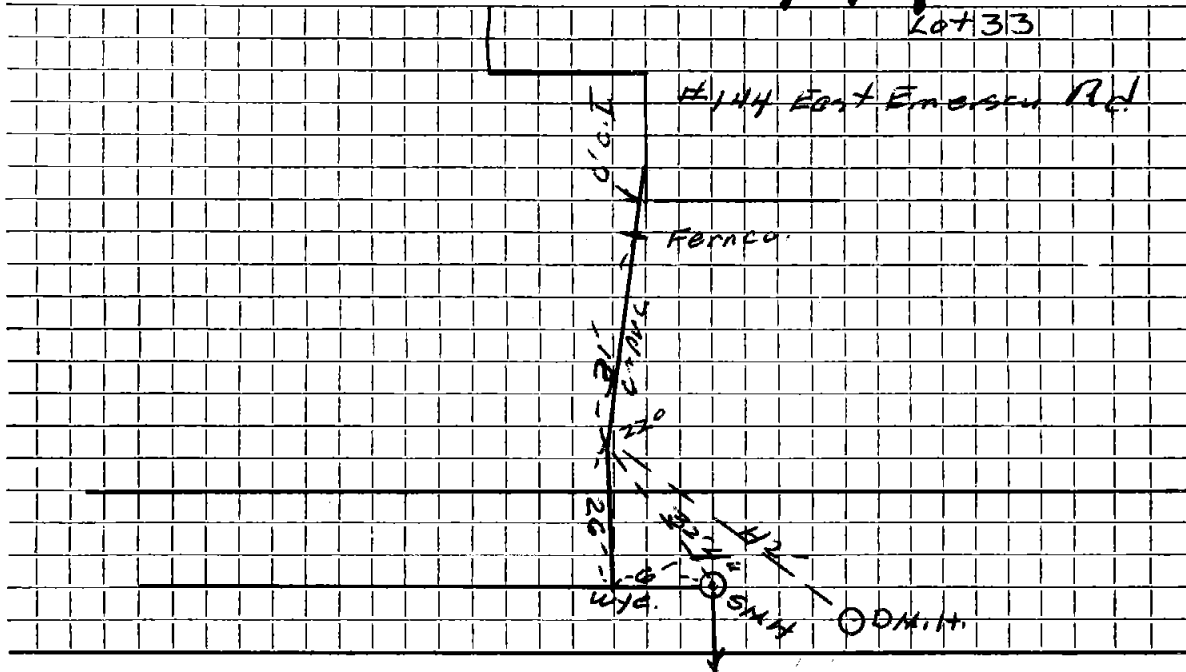

Connection made in Street. Work completed

Remarks:
.....
.....