


DATE _____

TOWN OF LEXINGTON — BOARD OF PUBLIC WORKS

SEWER DIVISION

Sketch of Service Here
LOT 20 NO 149 EAST EMERSON 149

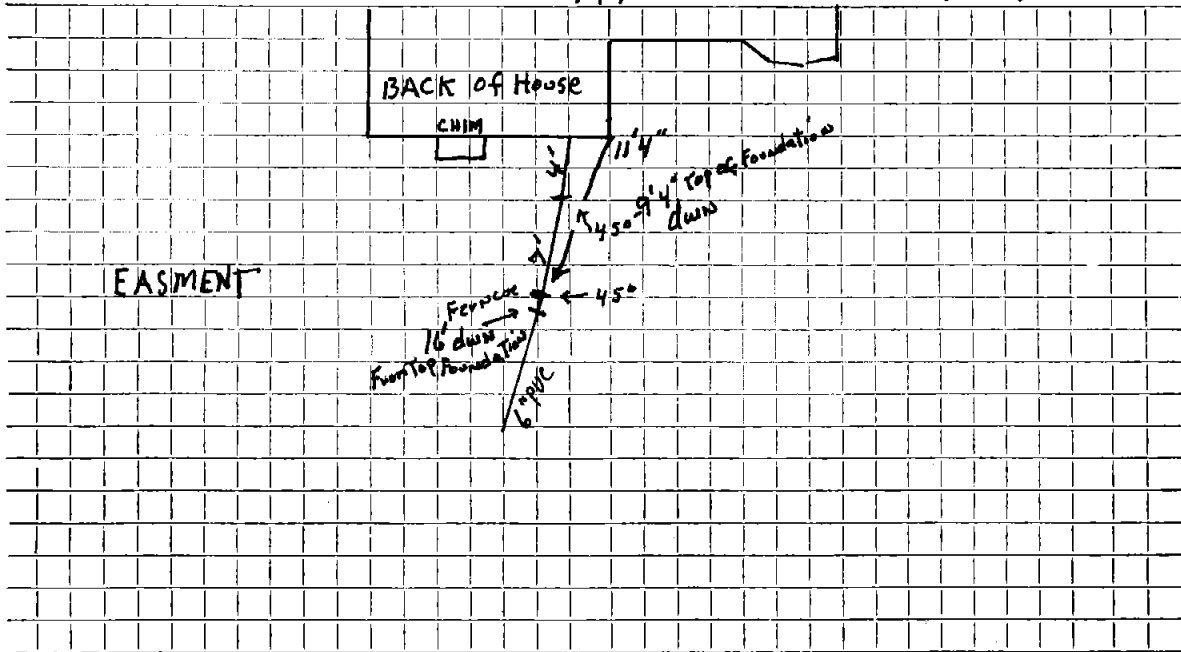

Connection made in Street. Work completed

Remarks: 6" WAS IN UP TO BACK OF HOUSE