



DATE \_\_\_\_\_


TOWN OF LEXINGTON — BOARD OF PUBLIC WORKS

SEWER DIVISION

Sketch of Service Here

150

LOT #34

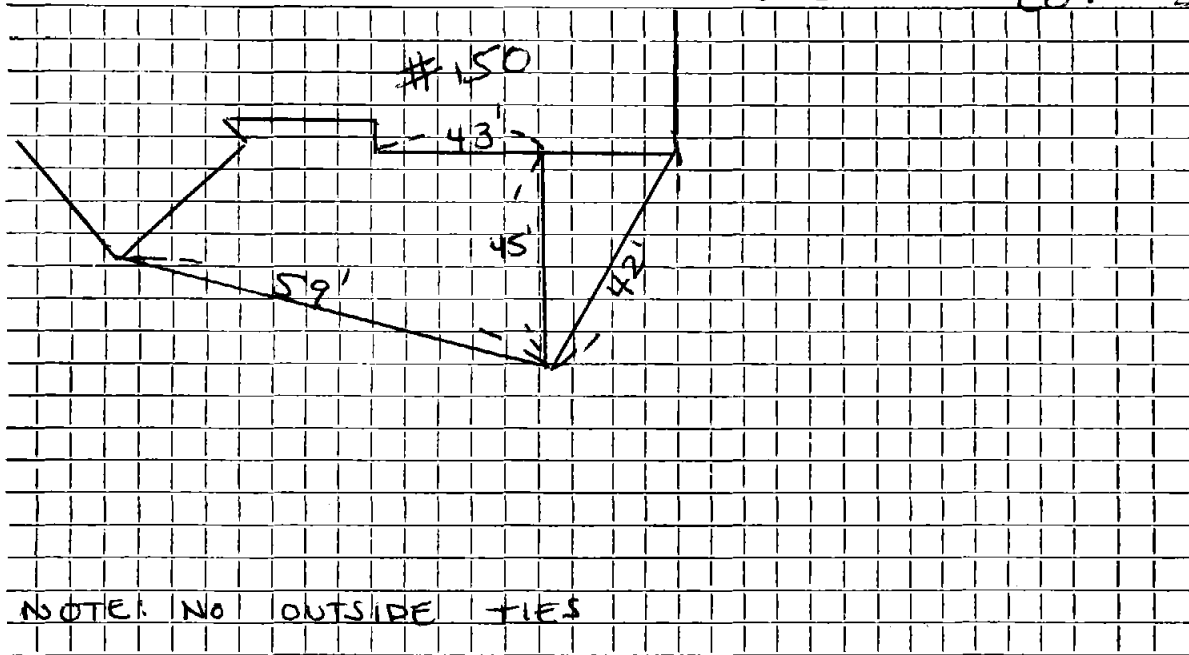

NOTE: NO OUTSIDE TIES

Connection made in EAST...EMERSON..... Street. Work completed .....

Remarks: .....

.....