

Name Prescott Village Realty Trust

Service No.

Address 155 East Emerson Road

Lot 19

Location

Kind of Pipe

Size

Size of Main

~~Repair - Removal~~ - New Service Arlex #3950

Location

Date

Material

Amount

Total

Date

Amount

3/13/85 40' x 6" PVC


10' x 4" PVC

6 x 4 Fernco

DATE MARCH 15, 1985

TOWN OF LEXINGTON — BOARD OF PUBLIC WORKS
SEWER DIVISION

Sketch of Service Here **155**

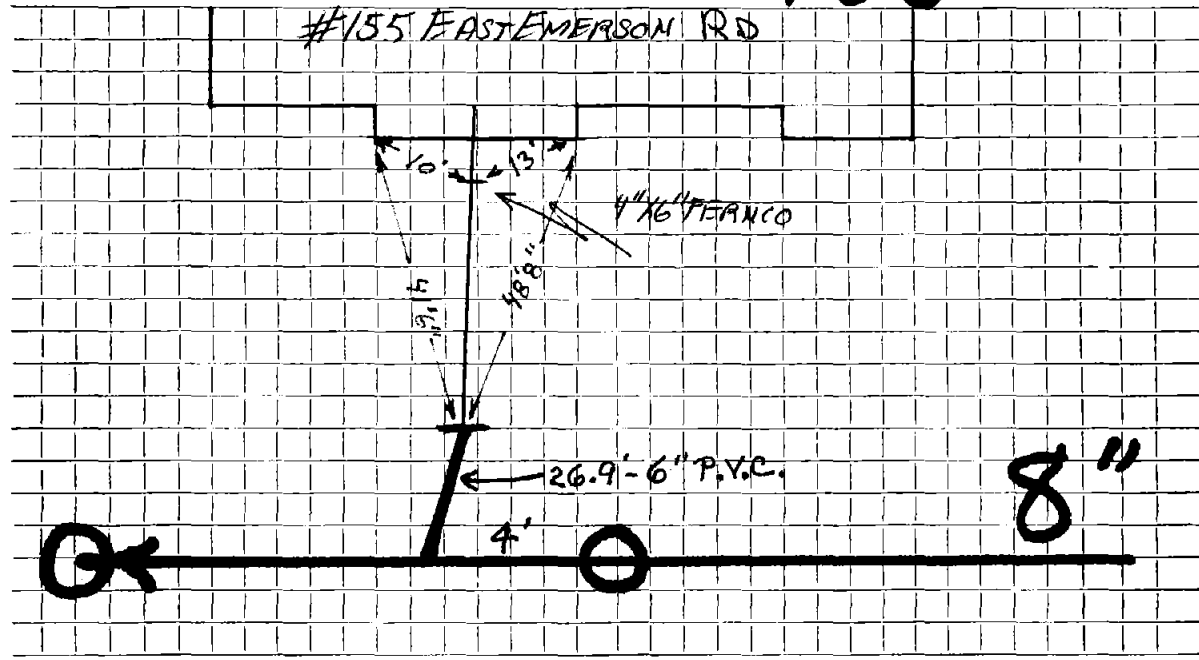

Connection made in EAST EMERSON RD Street.

Work completed MARCH 1985

Remarks:

.....

.....