


DATE MARCH 14, 1985

TOWN OF LEXINGTON — BOARD OF PUBLIC WORKS
SEWER DIVISION

Sketch of Service Here **164**

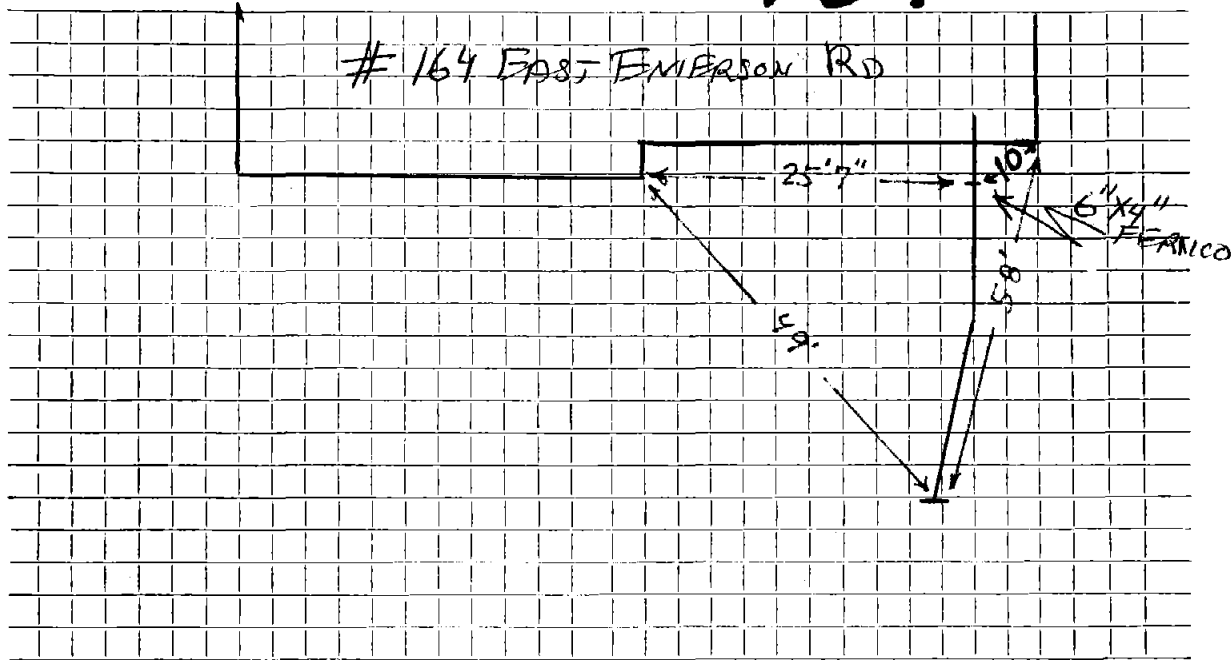

Connection made in Street. Work completed MARCH 1985

Remarks:

.....

.....