


DATE _____

TOWN OF LEXINGTON — BOARD OF PUBLIC WORKS

SEWER DIVISION

Sketch of Service Here

167

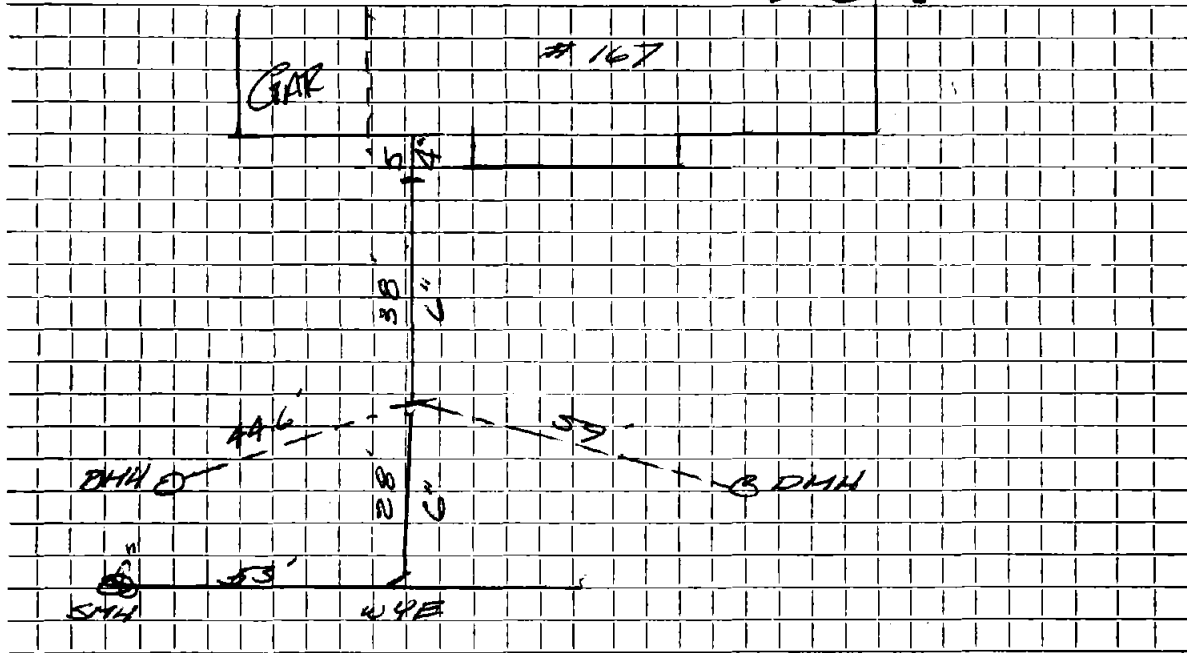

Connection made in EAST EMERSON Street. Work completed

Remarks: