

Name

Service No.

Address 168 East Emerson Rd.

(Lot 37)

Location

Kind of Pipe PVC

Size 6"

Size of Main 8"

Repair—Renewal—New Service

Location


Date	Material	Amount	Total		Date	Amount	
	<del>40' (6" PVC)</del>	N.C.					

6" P.V.C.

DATE \_\_\_\_\_

TOWN OF LEXINGTON — BOARD OF PUBLIC WORKS  
SEWER DIVISION

Sketch of Service Here

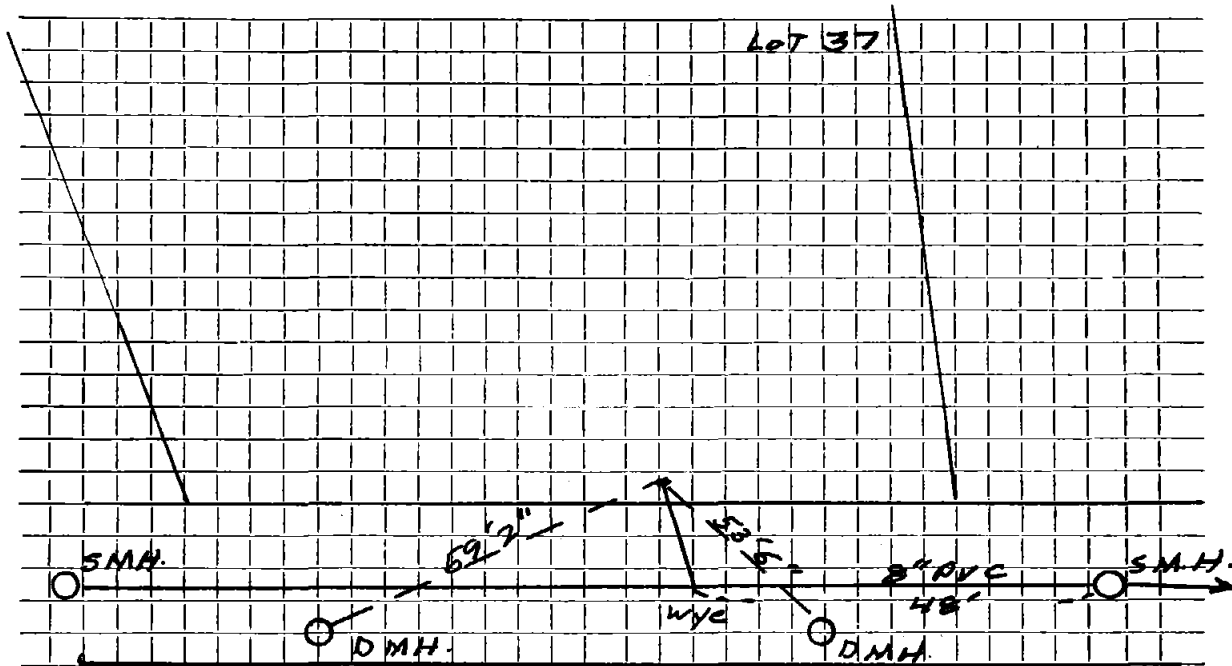

Connection made in ... East Emerson Rd Street.

Work completed .....

Remarks: .....

.....

.....