


DATE MARCH 14, 1985

TOWN OF LEXINGTON — BOARD OF PUBLIC WORKS

SEWER DIVISION

Sketch of Service Here

171

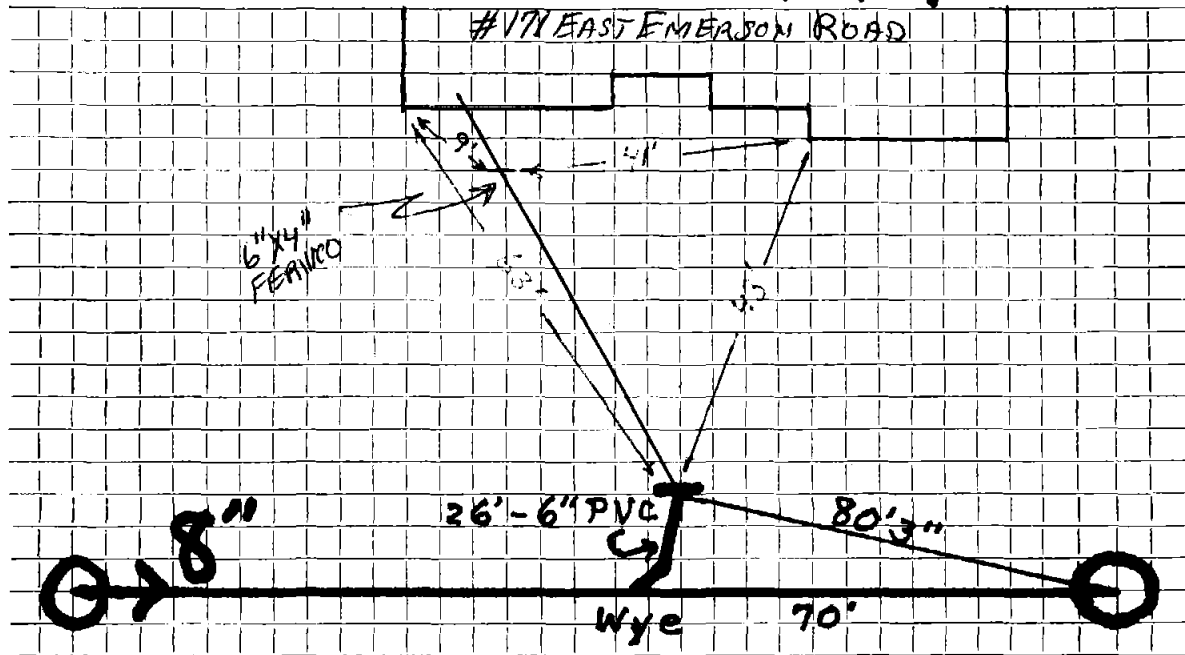

Connection made in EAST EMERSON ROAD Street.

Work completed MARCH 1985

Remarks:

.....

.....