


DATE July 6, 1984

TOWN OF LEXINGTON — BOARD OF PUBLIC WORKS
SEWER DIVISION

Sketch of Service Here **172**

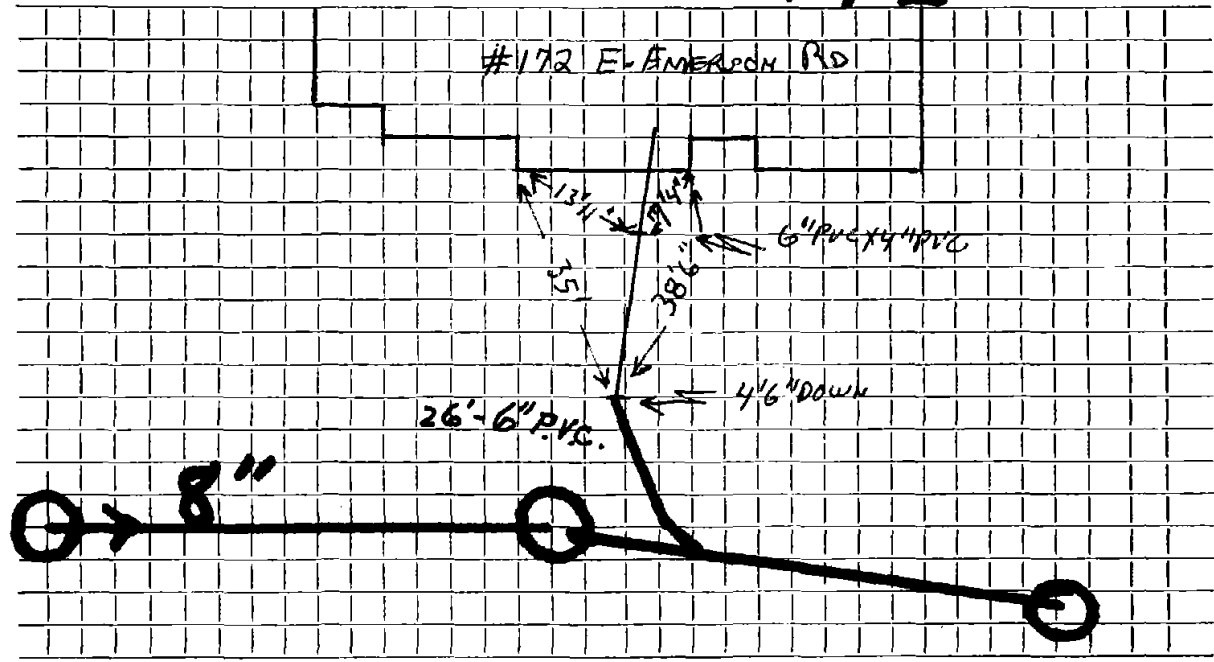

Connection made in E. EMERSON RD Street. Work completed July 6, 1984

Remarks:

.....

.....