


DATE _____

TOWN OF LEXINGTON — BOARD OF PUBLIC WORKS

SEWER DIVISION

Sketch of Service Here

176

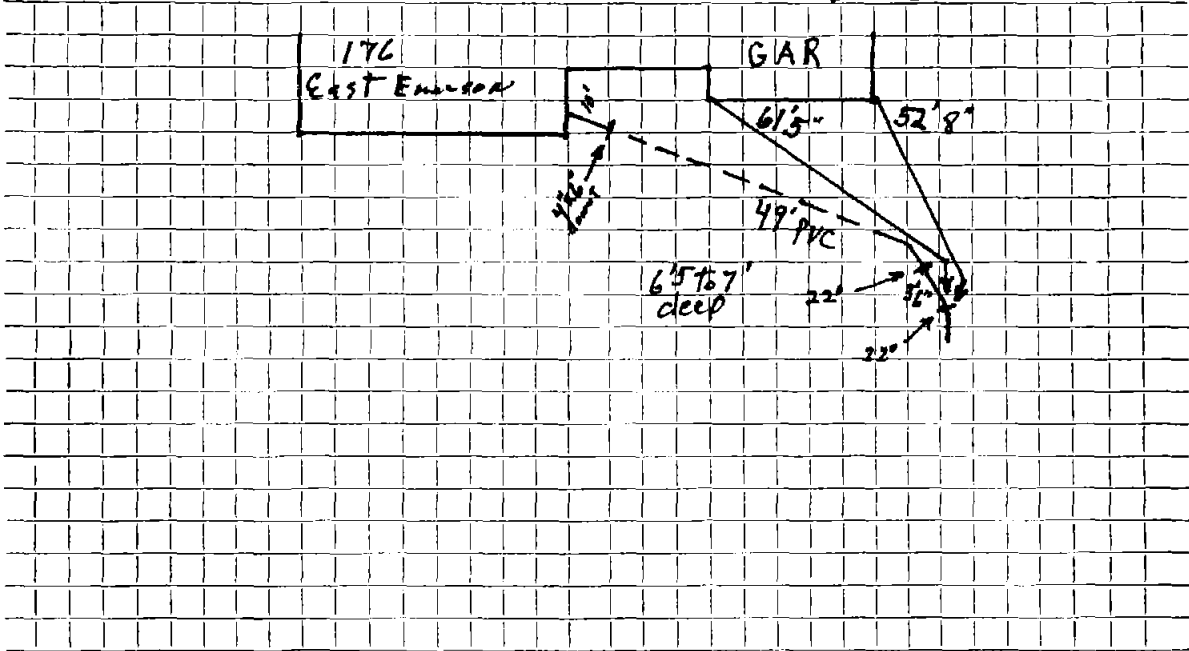

Connection made in Street. Work completed

Remarks: *Water in same trench as sewer 1 1/2' above sewer right side trench*

.....
.....