


DATE MAY 20, 1983

TOWN OF LEXINGTON — BOARD OF PUBLIC WORKS
SEWER DIVISION

Sketch of Service Here

180

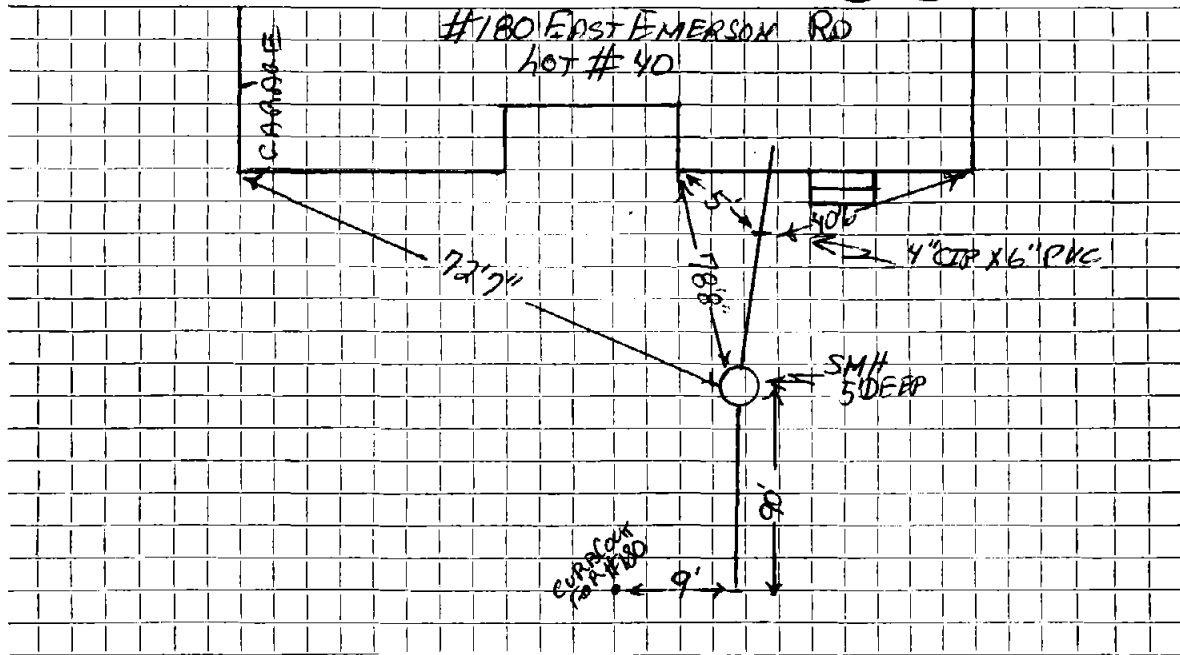

Connection made in EAST EMERSON RD Street.

Work completed ... MAY 1983

Remarks: NO OUTSIDE INFORMATION

.....
.....