


DATE _____

TOWN OF LEXINGTON — BOARD OF PUBLIC WORKS
SEWER DIVISION

Sketch of Service Here **184**

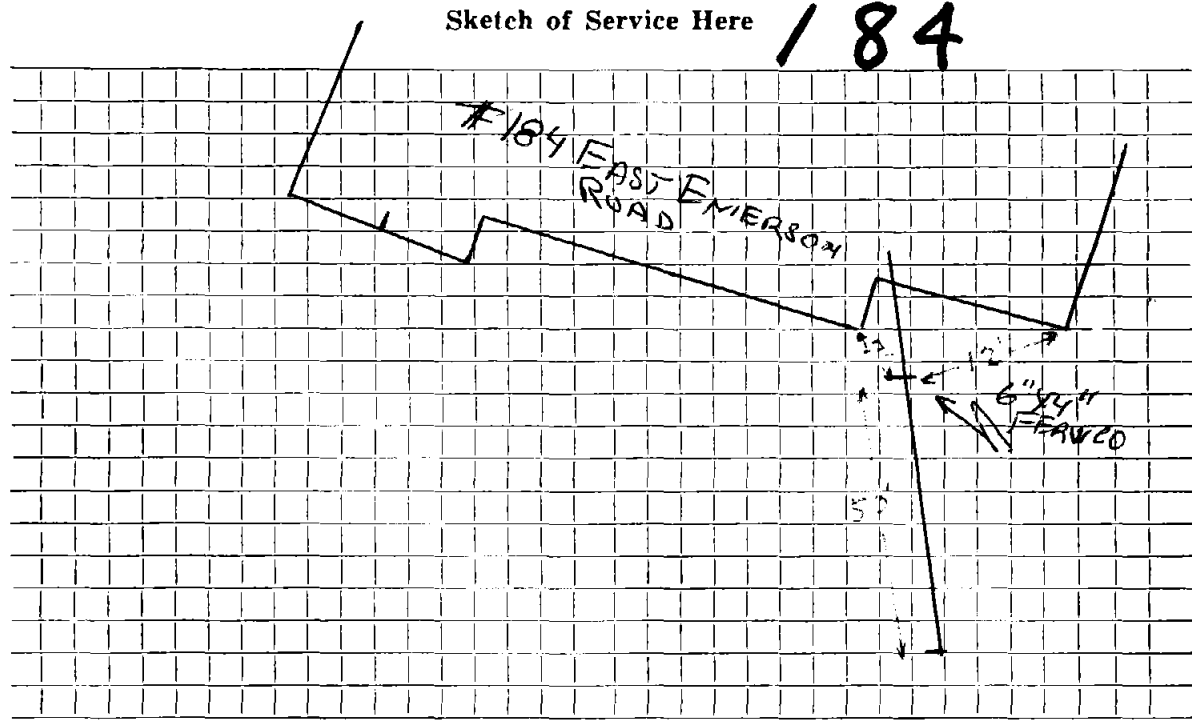

Connection made in Street.

Work completed . **MARCH 1985**

Remarks:
.....
.....