




DATE MAY 20, 1983

TOWN OF LEXINGTON — BOARD OF PUBLIC WORKS  
SEWER DIVISION

Sketch of Service Here

**188**

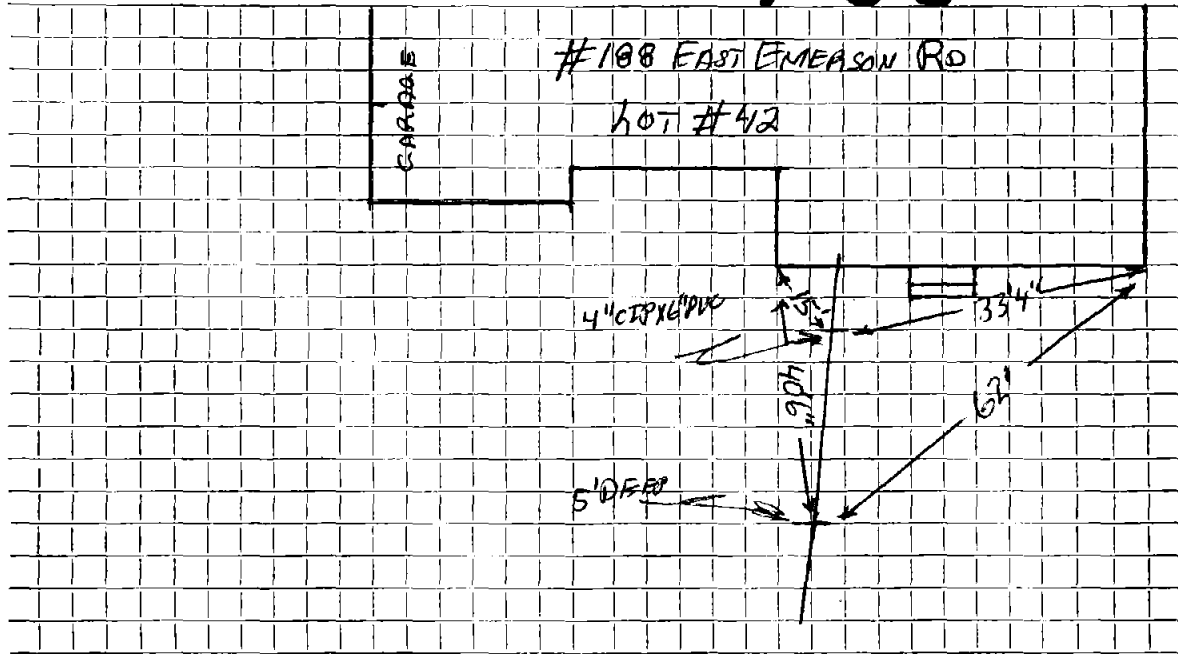

Connection made in E. EMEASON RD Street.

Work completed MAY 1983

Remarks: NO OUTSIDE INFORMATION