


DATE MAY 16, 1983

TOWN OF LEXINGTON — BOARD OF PUBLIC WORKS
SEWER DIVISION

Sketch of Service Here **200**

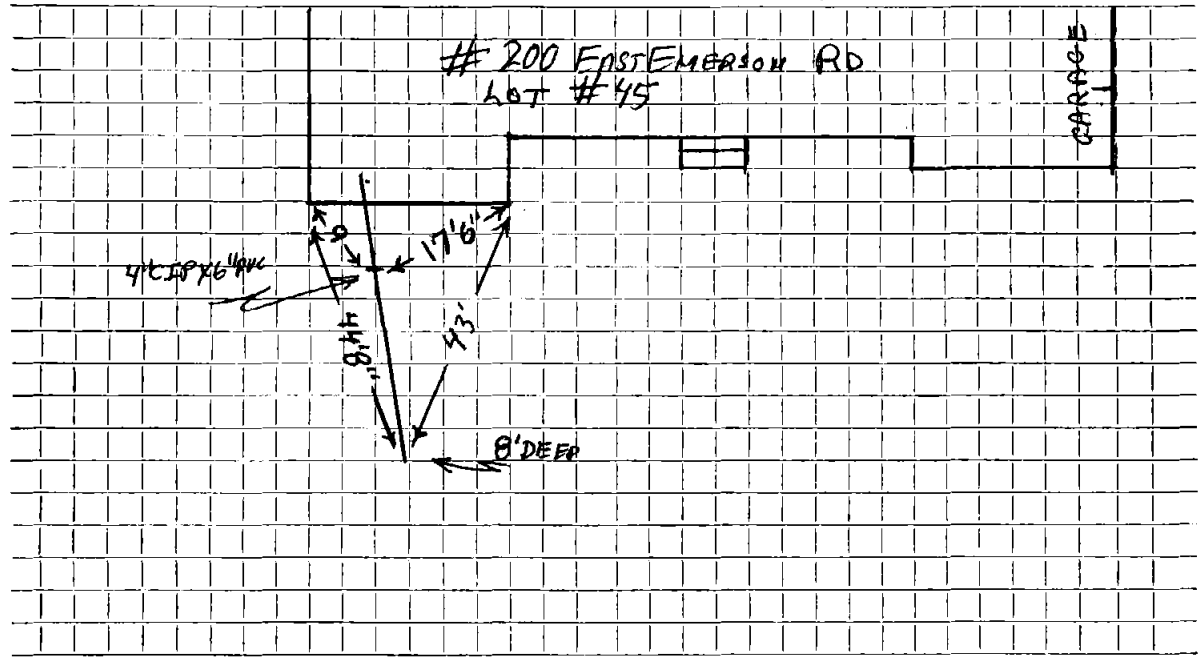

Connection made in EAST EMERSON RD Street. Work completed MAY 1983

Remarks:

.....

.....