

DATE _____


TOWN OF LEXINGTON — BOARD OF PUBLIC WORKS

SEWER DIVISION

Sketch of Service Here

205

LOT #13

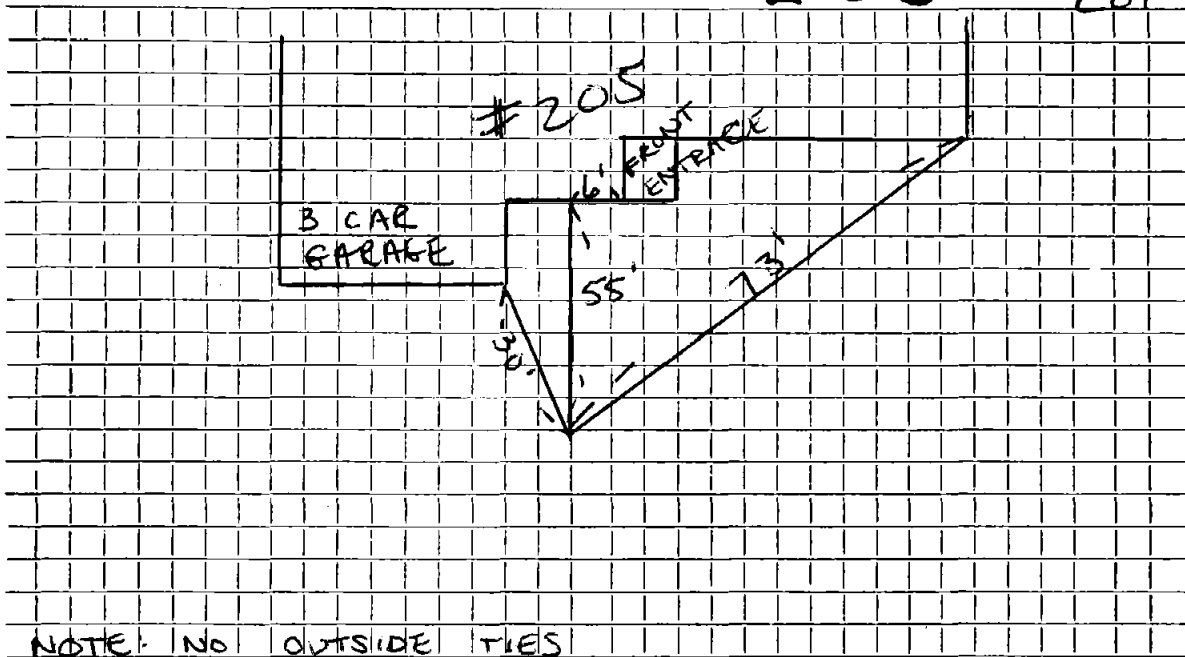

Connection made in EAST... EMERSON..... Street.

Work completed

Remarks:

.....