




DATE \_\_\_\_\_

TOWN OF LEXINGTON — BOARD OF PUBLIC WORKS  
SEWER DIVISION

Sketch of Service Here **211**  
Lot 11

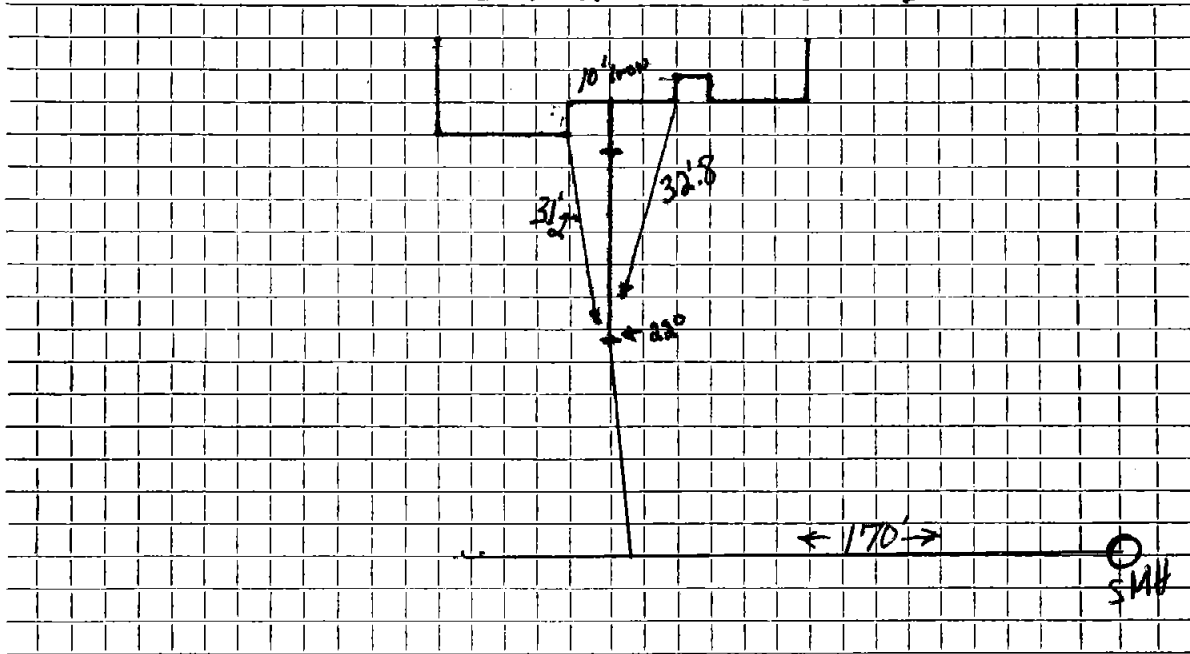

Connection made in ..... Street. Work completed .....

Remarks: **211 East Emerson ?**