




DATE 12-23-82

TOWN OF LEXINGTON — BOARD OF PUBLIC WORKS  
SEWER DIVISION

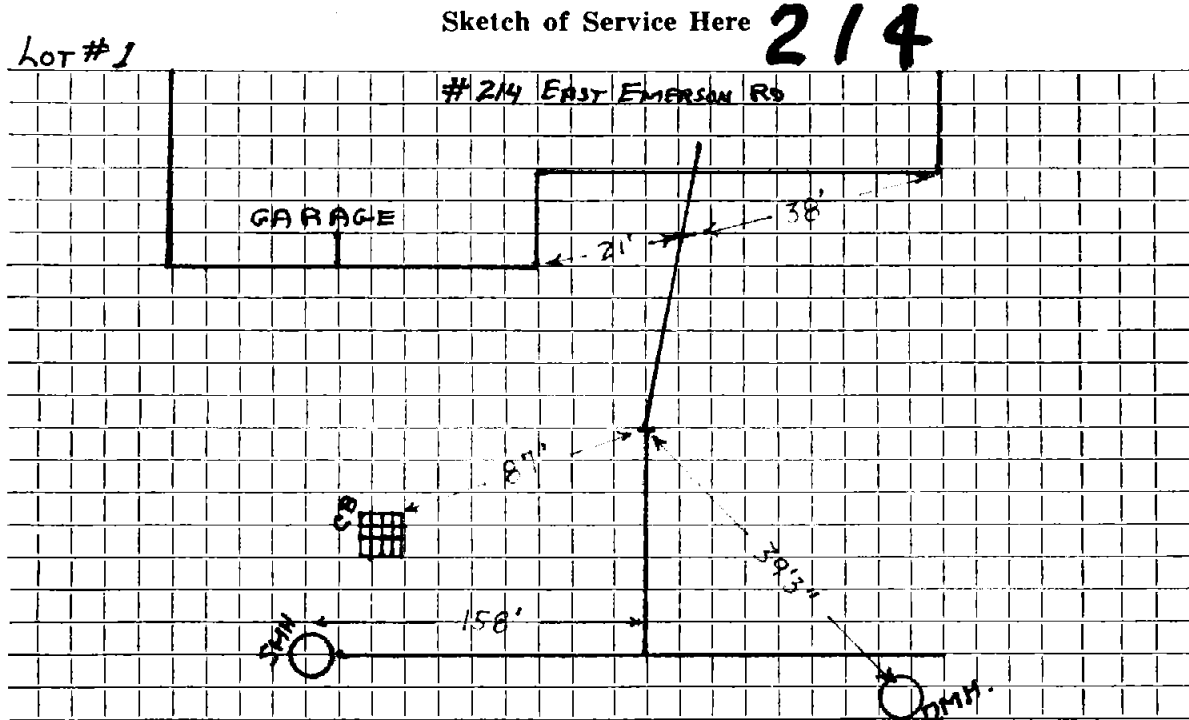

Connection made in EAST EMERSON RD Street. Work completed 11-82

Remarks: .....

.....

.....