


DATE 1982

TOWN OF LEXINGTON — BOARD OF PUBLIC WORKS
SEWER DIVISION

Sketch of Service Here **218**

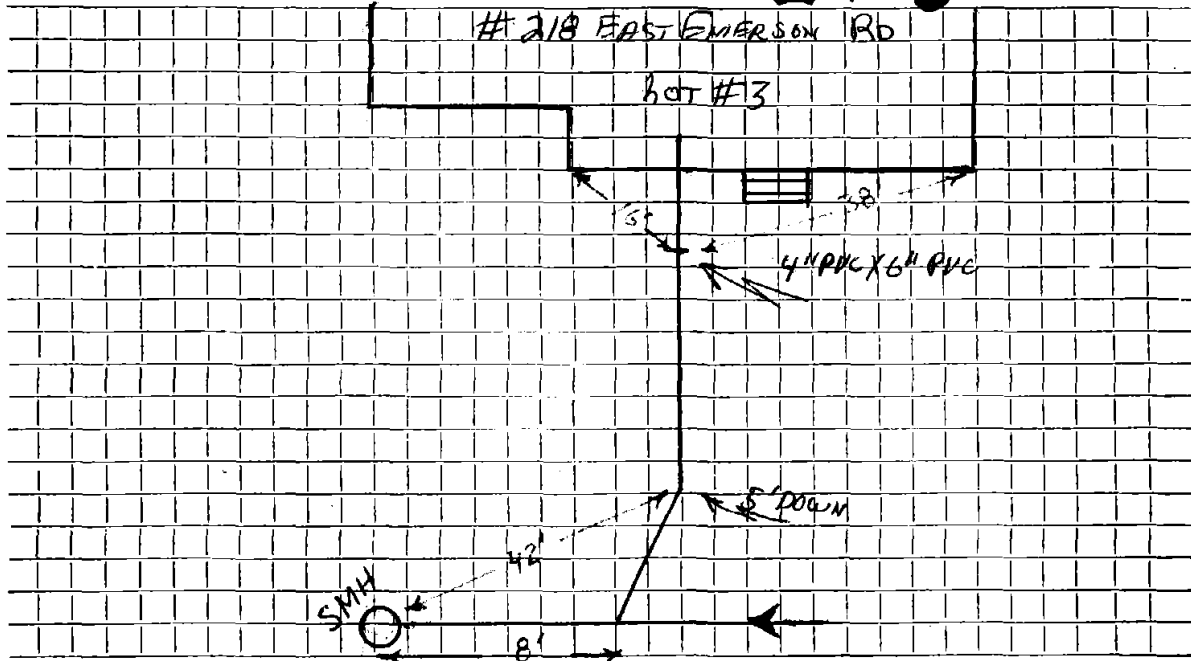

Connection made in EAST EMERSON RD Street. Work completed OCT. 14, 1983

Remarks:

.....

.....