

Name **Bicentennial Builders Corp.**

Service No.

Address **# 221 EAST EMERSON RD**

Location

Kind of Pipe

Size

Size of Main

~~Repair~~—~~Renewal~~—New Service **Arlex #3765**

Location

Date		Material	Amount	Total	Date	Amount
------	--	----------	--------	-------	------	--------

Nov. '82	24'	6" P.V.C. Pipe				
----------	-----	----------------	--	--	--	--

	10'	4" C.I. Pipe				
--	-----	--------------	--	--	--	--

	1	6" x 4" Donut				
--	---	---------------	--	--	--	--

OUTSIDE


6" P.V.C. Pipe

DATE 11-82

TOWN OF LEXINGTON — BOARD OF PUBLIC WORKS

SEWER DIVISION

Sketch of Service Here **221**

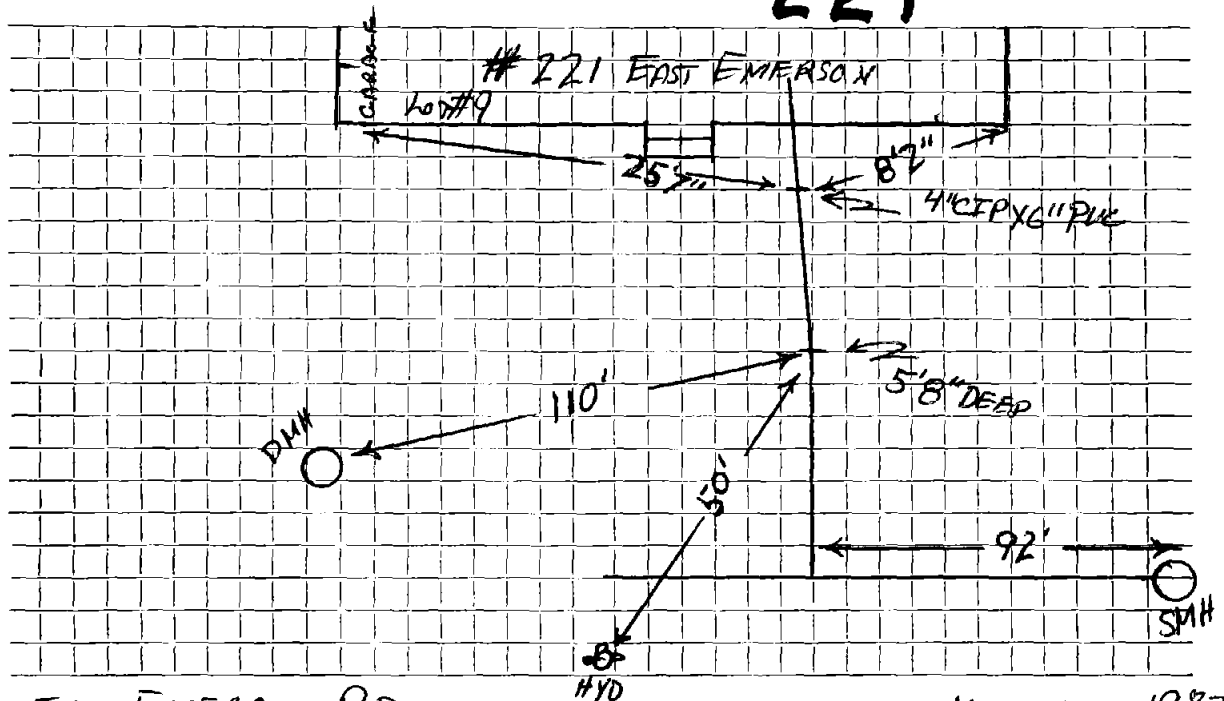

Connection made in EAST EMEASON RD Street. Work completed NOVEMBER 1982

Remarks: .....