

Name *Bicentennial Builders Corp.*

Service No.

Address *227 East Emerson Road*

Lot #8

Location

Kind of Pipe

Size

Size of Main

~~Repair/Removal~~ *New Service Arlex #4489*

Location


Date		Material	Amount	Total	Date	Amount
10/13/83	30'	6" P.V.C.				
	1	6" 22° Bend				

65'x6" PVC OUTSIDE

DATE _____

TOWN OF LEXINGTON — BOARD OF PUBLIC WORKS
SEWER DIVISION

Sketch of Service Here **227**

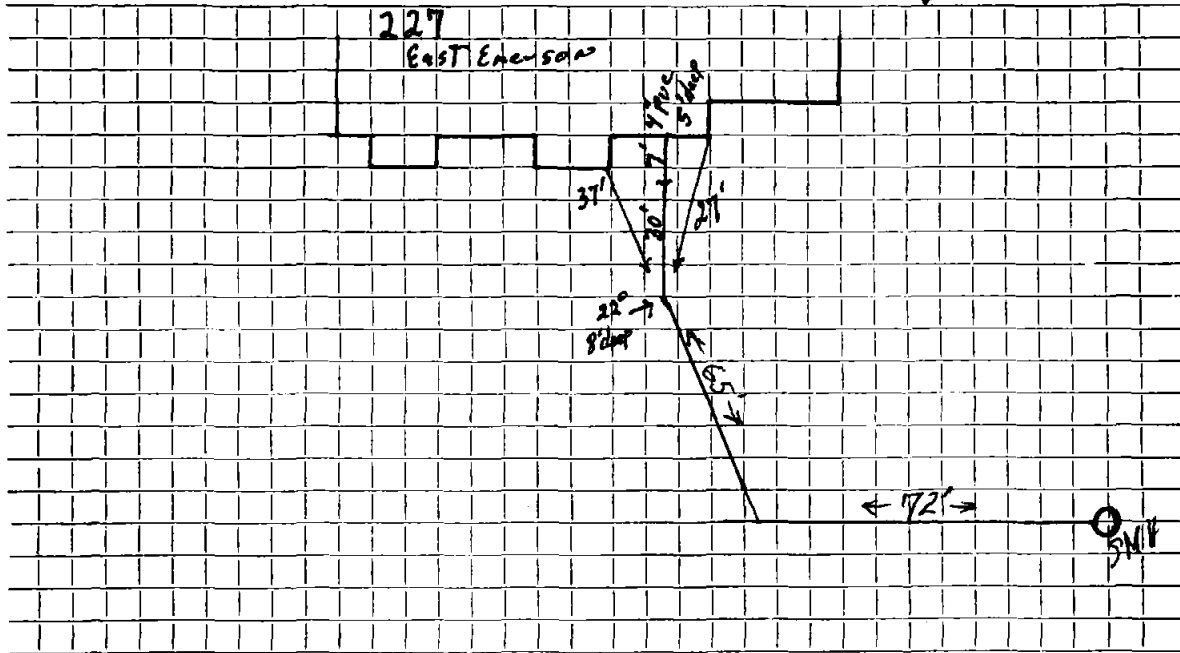

Connection made in Street. Work completed

Remarks:

.....

.....