


DATE 12-23-82

TOWN OF LEXINGTON — BOARD OF PUBLIC WORKS
SEWER DIVISION

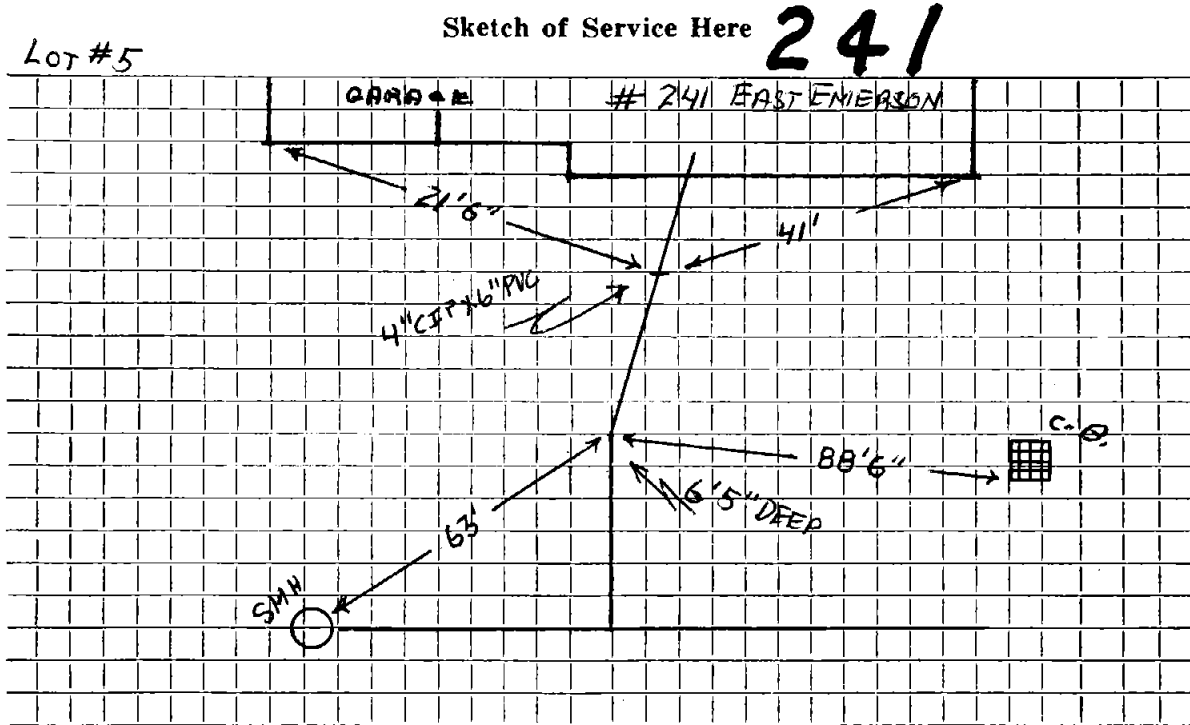

Connection made in EAST EMERSON RD Street. Work completed 11-82

Remarks:

.....

.....