

Name

Service No.

Address 204 EAST ST

MCLUGHLIN

Location

Kind of Pipe

Size

Size of Main

Repair—Renewal—New Service

Location

Date

Material

Amount

Total

Date

Amount

7/24/12

6" SDN

6' CLEAN OUT

. 6" PVC CAP

. 6" TEE W/VE


. 6" SPIL RUBER

6" 22' BEND

DATE 2/2017

TOWN OF LEXINGTON — BOARD OF PUBLIC WORKS
SEWER DIVISION

Sketch of Service Here

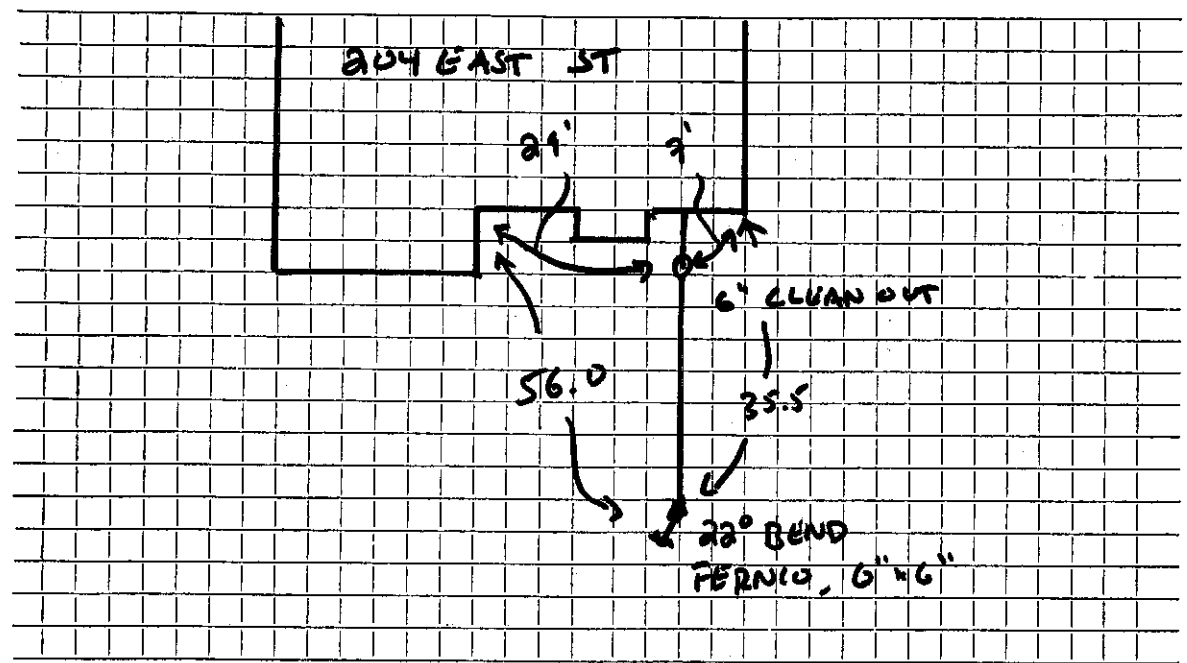

Connection made in EAST Street. Work completed MULLAUGH LIN

Remarks:

.....

.....