

Name *Morisso Liggiero*

Service No.

Address *229 East Street*

Location

Kind of Pipe

*SDR 35*

Size

*6" PVC*

Size of Main

Repair—Renewal—

New Service

Location

Date	Material	Amount	Total	Date		Amount
------	----------	--------	-------	------	--	--------

*Direct connection to main*

*1*

*Cleanout w/wye*

*1*

*Ferroc connection*

*1*


*6" SDR 35*

DATE 6/1/18

TOWN OF LEXINGTON — BOARD OF PUBLIC WORKS

SEWER DIVISION

Sketch of Service Here

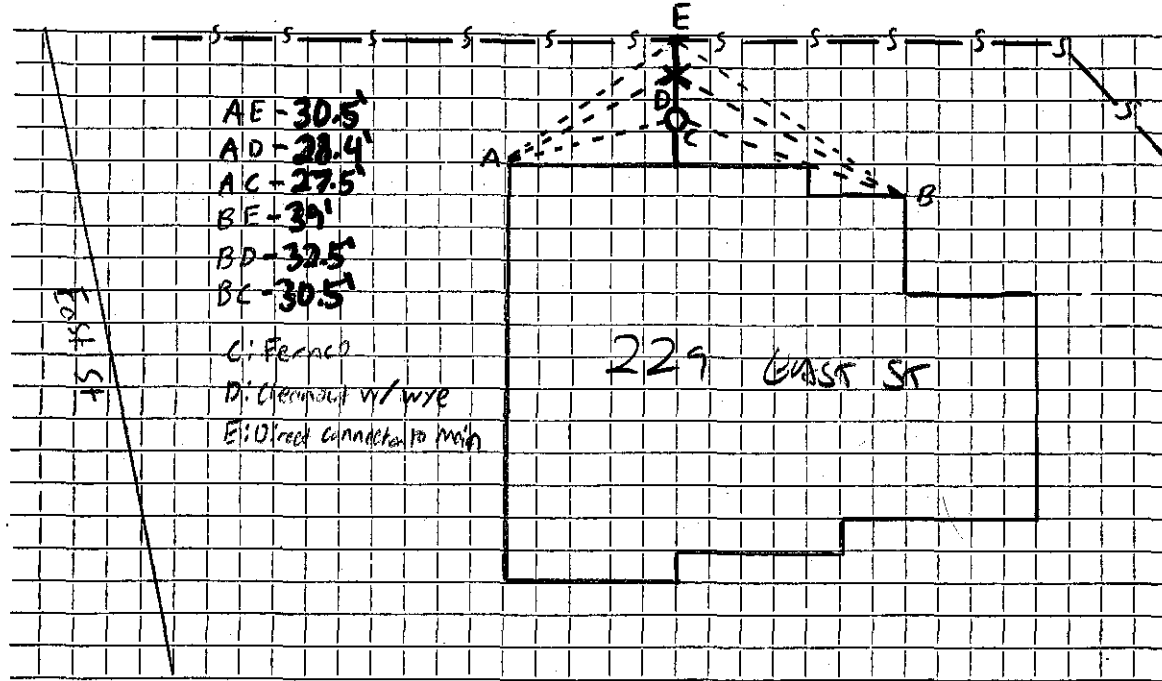

AE - 30.5'  
 AD - 28.4'  
 AC - 27.5'  
 BE - 30'  
 BD - 32.5'  
 BC - 30.5'  
 C: Fence  
 D: Cleanout w/ wye  
 E: Direct connection to main

Connection made in Easement off East Street. Work completed .....

Remarks: Cleanout Depth: 5' Total Depth: 7'8"