

Name Moore Homes

Service No. 112 N.D.

Address 115 EAST ST (VACANT LOT

(OPP. HSE #119

Location

Kind of Pipe

Size 6" A.C

Size of Main 8"

Repair—Renewal—New Service

Location JAN 21 1980

Date	Material	Amount	Total	Date	Amount
------	----------	--------	-------	------	--------

6-18-73	35' 6" A.C.	9.00	315.00	1-21-80	Paid by S/C #64	315.00
--------------------	------------------------	-----------------	-------------------	---------	-----------------	--------

6-18-73


35' 6" A.C.

DATE _____

TOWN OF LEXINGTON — BOARD OF PUBLIC WORKS

SEWER DIVISION

Sketch of Service Here

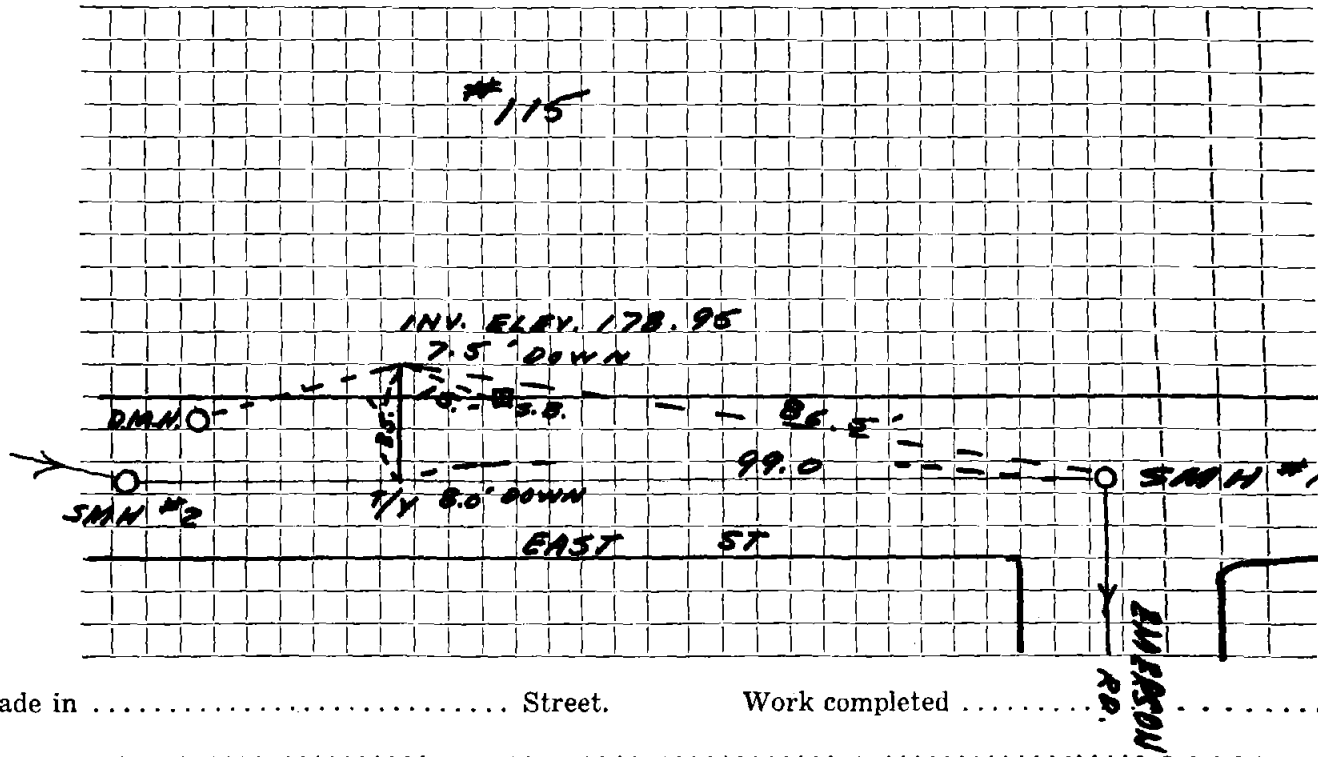

Connection made in Street. Work completed

Remarks:

.....
.....