

Name Moore Homes

Service No. 113 N.D.

Address 123 EAST ST. (OPP. VACANT LOT #119)

MARK TO USE

(VACANT LOT)

Location

Kind of Pipe

Size 6" A.C.

Size of Main 8"

Repair—Renewal—New Service

Location JAN 21 1980


Date	Material	Amount	Total	Date	Amount
11/8/73	60' 6" A.C.	9.00	540.00	1-21-80	Paid by SHP #64 26.30
				2-22-80	Paid 513.50
					<u>540.00</u>
				6-18-73	
					60' 6" A.C.

DATE _____

TOWN OF LEXINGTON — BOARD OF PUBLIC WORKS

SEWER DIVISION

Sketch of Service Here

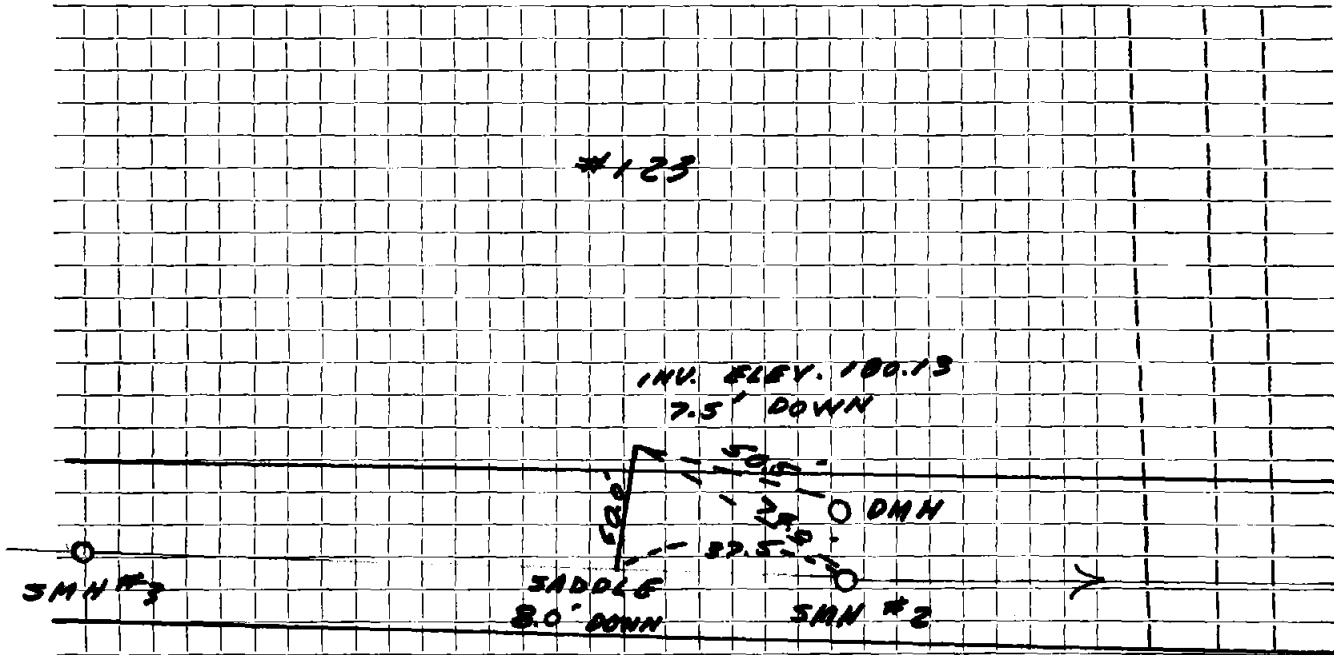

Connection made in Street. Work completed

Remarks:

.....
.....