

Name Contractor: JW Sullivan Corp.

Service No.

Address 130 East St

Location

Kind of Pipe SDR 35 PVC

Size 6"

Size of Main

Repair ~~Renewal~~ New Service


Location

Date	Material	Amount	Total	Date	Amount
4/24/20	6" Cleanout				
	6" SDR 35 PVC	5'			
	6" - 22° bend				
	6" SDR 35 PVC	10'			
	6" - 22° bend				
	6" SDR 35 PVC	41'			
	6" - 22° bend				
	6" SDR 35 PVC	13'			
	6" - 22° bend				
	6" Cleanout				
	6" SDR 35 PVC	60'			
	6" - 11° bend				
	6" Fern Co				

DATE 4/24/20

TOWN OF LEXINGTON — BOARD OF PUBLIC WORKS
SEWER DIVISION

Sketch of Service Here

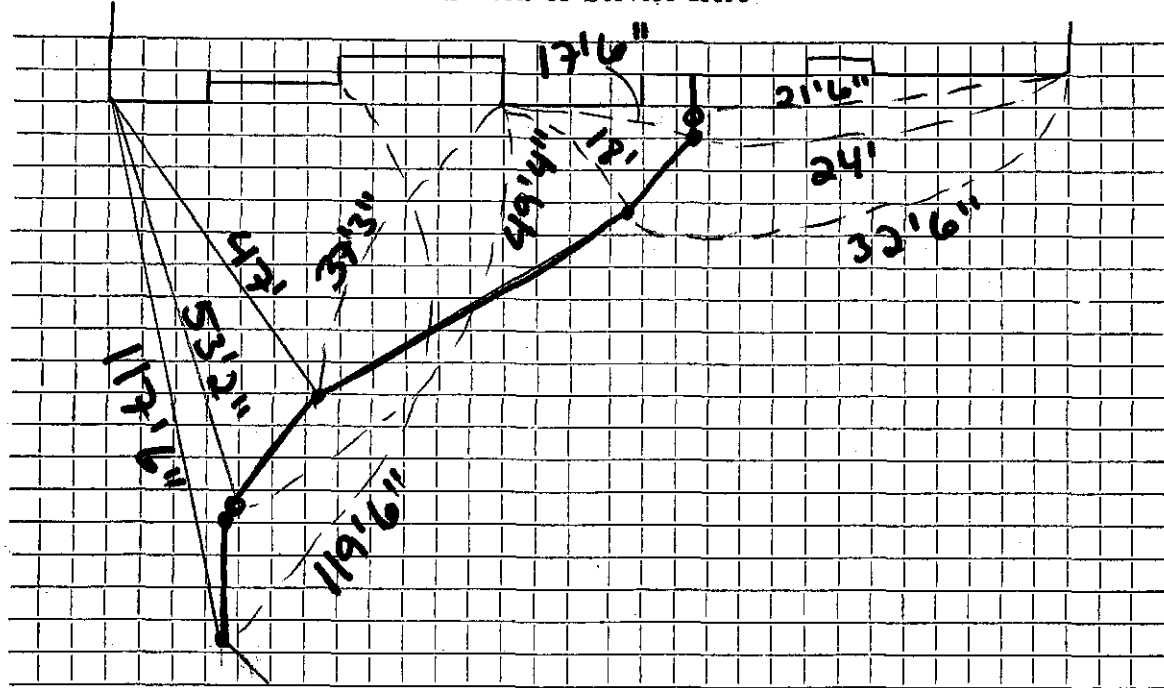

Connection made in Street. Work completed


Remarks:
.....
.....

DATE 4/24/20

TOWN OF LEXINGTON — BOARD OF PUBLIC WORKS
SEWER DIVISION

Sketch of Service Here

130

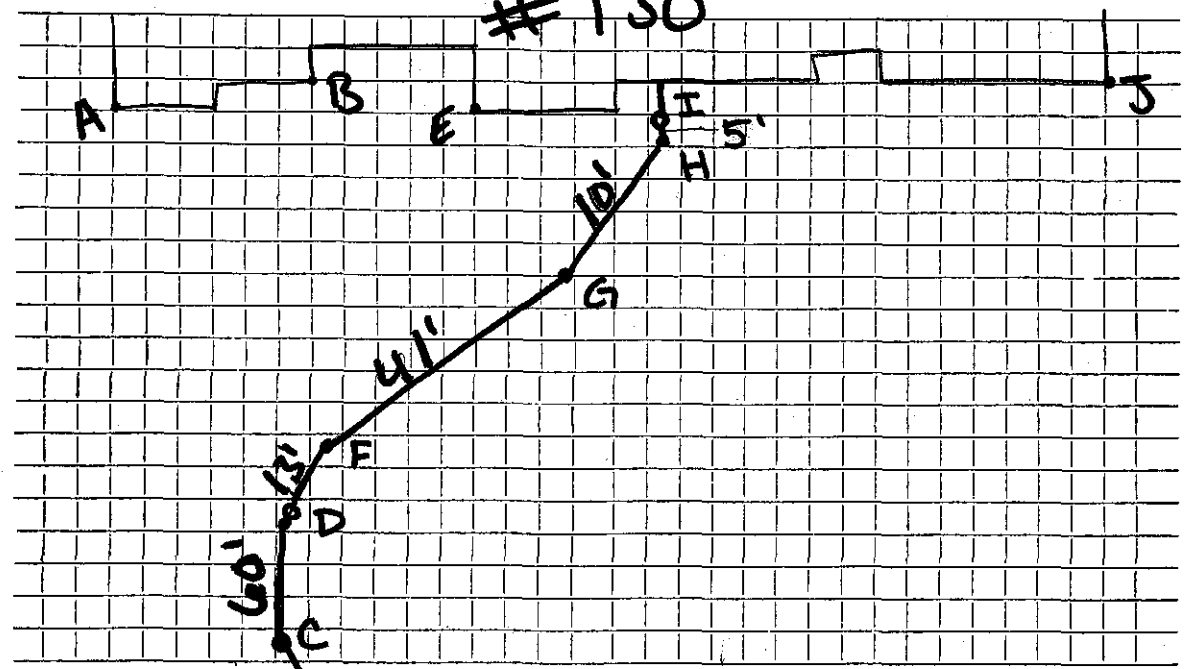

AC = 117'6"
BC = 119.6"
AD = 53'2"
ED = 49'4"
AF = 47'
EF = 37'3"
EG = 18'
JG = 32'6"
EH = 17'6"
JH = 24'
EI = 16'3"
JI = 21'6"

I = 6" cleanout
H = 6" - 22° bend
G = 6" - 22° bend
F = 6" - 22° bend
D = 6" cleanout
at 22° bend
C = 6" Ferro
at 11° bend

Connection made in East St Street. Work completed

Remarks: