

Service No.

DATE

Name

TOWN OF LEXINGTON — BOARD OF PUBLIC WORKS

Address

SEWER DIVISION

Size of Main

Size

Kind of Pipe

Location

Sketch of Service Here

Repair—Renewal—New Service

Amount

Date

Total


Amount

Material

Date

#135

INK ELEV. 179.50
7.5' DOWN

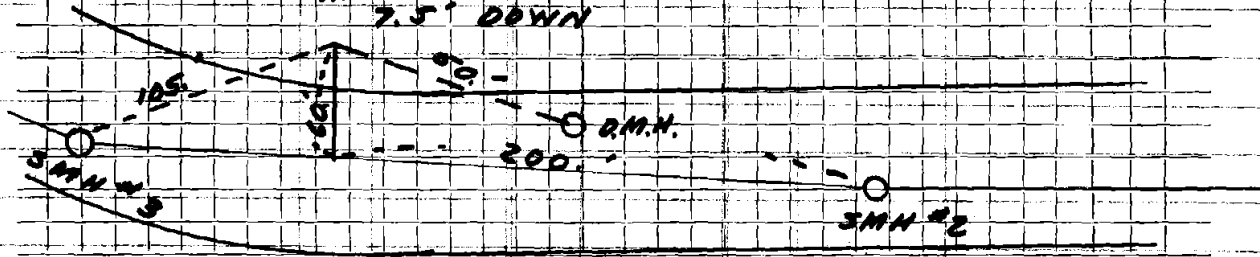

Connection made in Street. Work completed

Remarks: