

Name **Walter J. McDonald**

Service No. **42**

Address **14 East Street**

Location

Kind of Pipe

Size

Size of Main

Repair—Renewal—**New Service**

Location **JUN 29 1964**

W O # 8637


Date	Material	Amount	Total	Date	Amount
1/25/64	Labor	77.93		5-27-64	446 66
1/26/64	"	74.43		1-29-64	25 95
1/27/64	"	41.25	193 61	5-27-65	23 83
	10% O. H.	19 36	212 97		449 78
140	6" Transite Pipe @ .82		114 80	10- - 63	
2	11 1/4" Transite Elbows @ 2.35		4 70	15' 6" A.C.	
1	22 1/2" Transite Elbow		2 35		
1	22 1/2" Transite Bend		4 09		
1	6" Adapter		1 52		
1	Bag Lime		60		
1	Bag Fertilizer		3 25		
3	Hrs. Town Shovel @ 6.50		19 50		
3	Hrs. Trucking @ 3.00		9 00		
1	Hr. Loader @ 5.00		5 00		
24	Yards Loam @ 3.00		72 00		
			449 78		
					<i>Bill 5-27 2383</i>

DATE _____

TOWN OF LEXINGTON — BOARD OF PUBLIC WORKS

SEWER DIVISION

Sketch of Service Here **14**

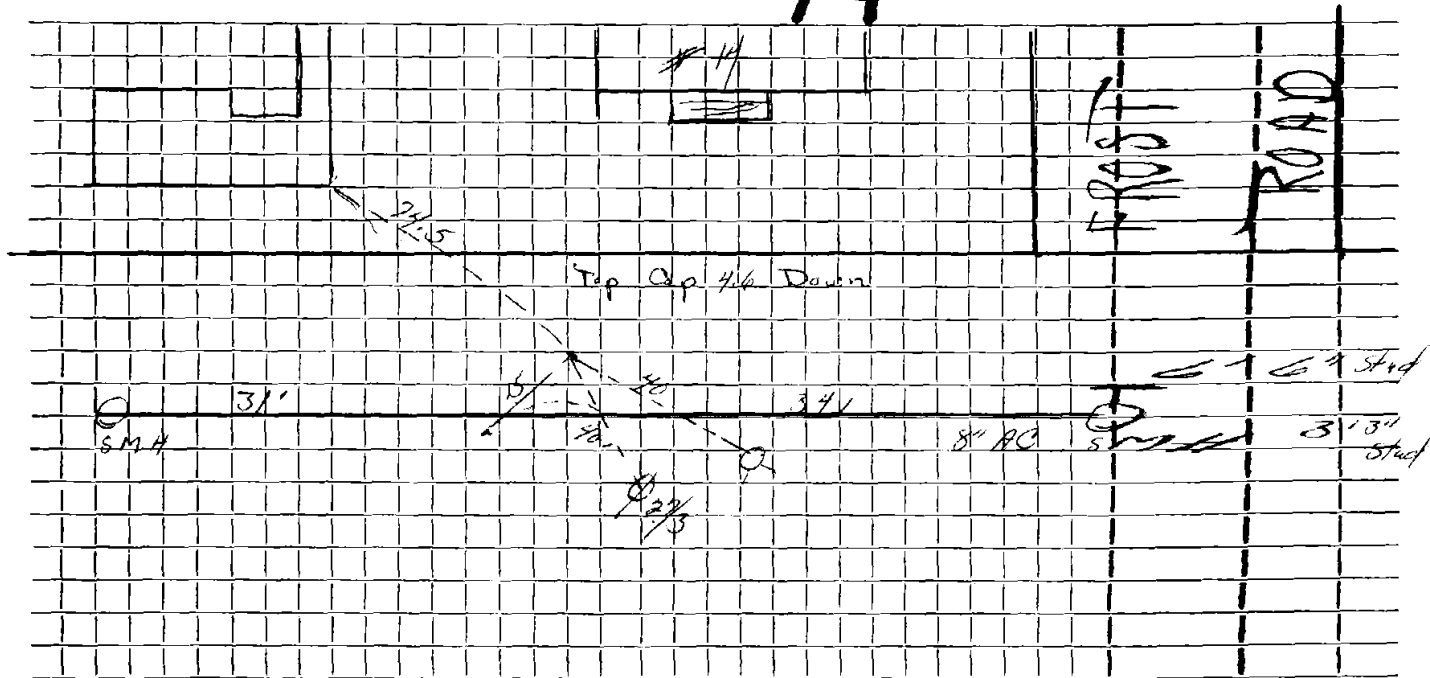

Connection made in Street. Work completed

Remarks:

.....

.....