

Name Moore Homes

Service No. 101

Address 141-143 EAST ST. (OPP. #199 EAST ST)
(VACANT LOT)

Location

Kind of Pipe

Size 6" A.C

Size of Main 8"

~~Repair/Renewal~~ New Service Melone #3518

Location JAN 21 1980

Date	Material	Amount	Total	Date	Amount	
<u>6/19/73</u>	<u>50' 6" A.C @ \$9.00</u>	<u>\$450.00</u>		<u>11/16-79</u>	<u>Deposit</u>	<u>450.00</u>
				<u>6-19-73</u>		
				<u>50' 6" A.C.</u>		

Services No.

DATE

Name

TOWN OF LEXINGTON — BOARD OF PUBLIC WORKS

Address

SEWER DIVISION

Size of Main

Size

Kind of Pipe

Location

Sketch of Service Here

Repair—Renewal—New Service

Amount

Date


Test

Amount

Material

Date

139

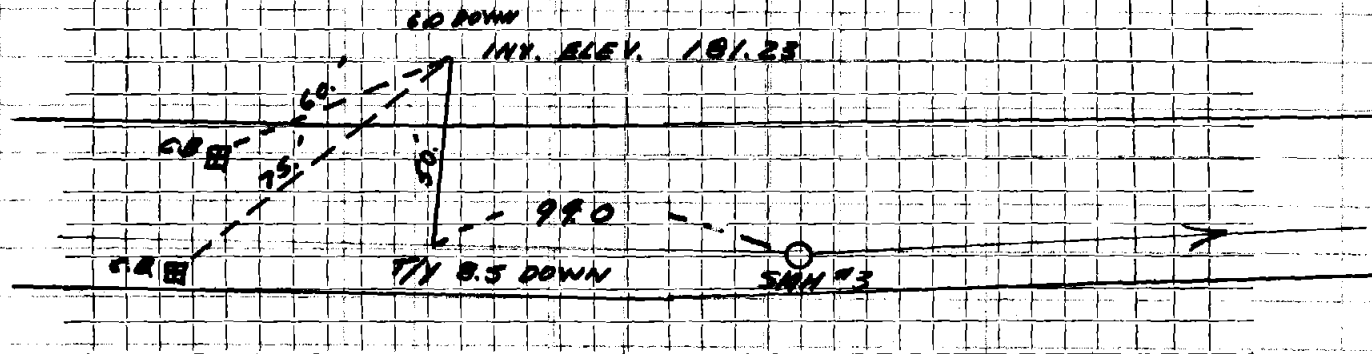

Connection made in Street. Work completed

Remarks:

.....

.....