

Name

Service No.

Address #144 EAST ST.

Location

Kind of Pipe

Size

6" A.C.

Size of Main

8" A.C.

Repair—Renewal—New Service

Location

Date

Material

Amount

Total

Date

Amount

~~4/9/72 15.0 A.C. @ 9.00 #135.00~~

11-9-72


15' 6" A.C.

DATE _____

TOWN OF LEXINGTON — BOARD OF PUBLIC WORKS

SEWER DIVISION

Sketch of Service Here

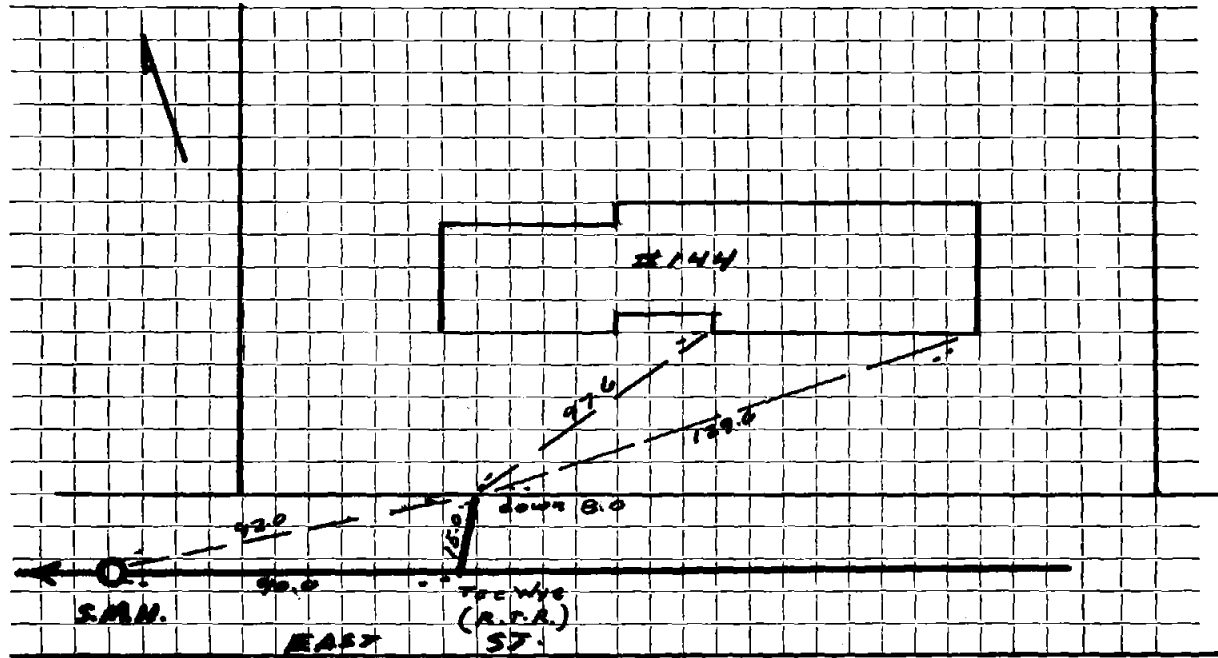

Connection made in Street. Work completed

Remarks:
.....
.....