
## TOWN OF LEXINGTON

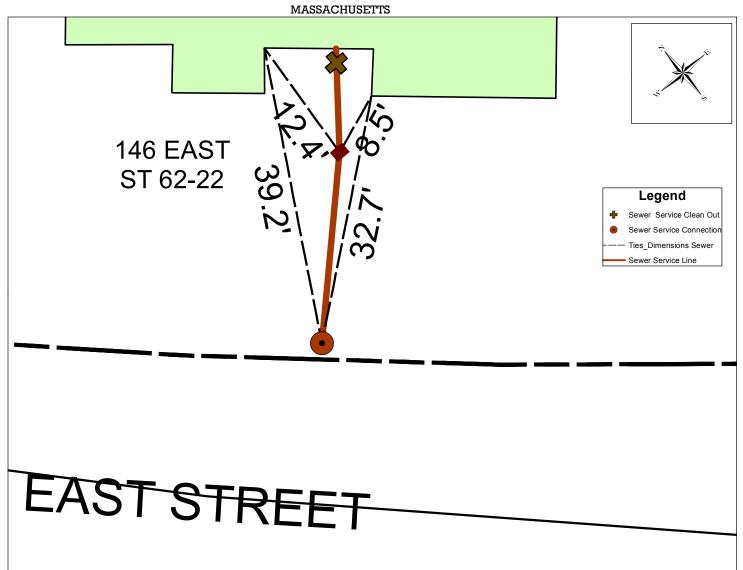

Address	Map and Lot	Permit Number	Contractor Name	Inspector
146 East St	62-22	5909	McLaughlin, James M. Inc.	msprague
Date	Material	Depth of Cover	Amount	
10/10/2014	6x6 AC to PVC Fern Co	8 ft	1-Connect to existing AC Line	
	6 " PVC Pipe - SDR 35		28.5 ft to 11 degree bend	
	PVC 11 Degree Bend		1	
	6 " PVC Pipe - SDR 35	7 ft	10 ft to HSE	
Type of work completed				
New 6" PVC sewer service installed to new house, connection to existing line.				