

Name Robert E. Doran

Service No. 168

Address #150 EAST ST.

Location

FEB 12 1973

Kind of Pipe

Size

Size of Main

Repair—Renewal—New Service

Bonnano #2177

Location

Date

Material

Amount

Total

Date

Amount

~~11/9/72 170.00 @ 9.00 153.00~~

11/6/72

Deposit

153 00

11/6/72 55' 6" Transite

10' 4" Cast Iron

11-9-72


17' 6" A.C.

DATE _____

TOWN OF LEXINGTON — BOARD OF PUBLIC WORKS

SEWER DIVISION

Sketch of Service Here **150**

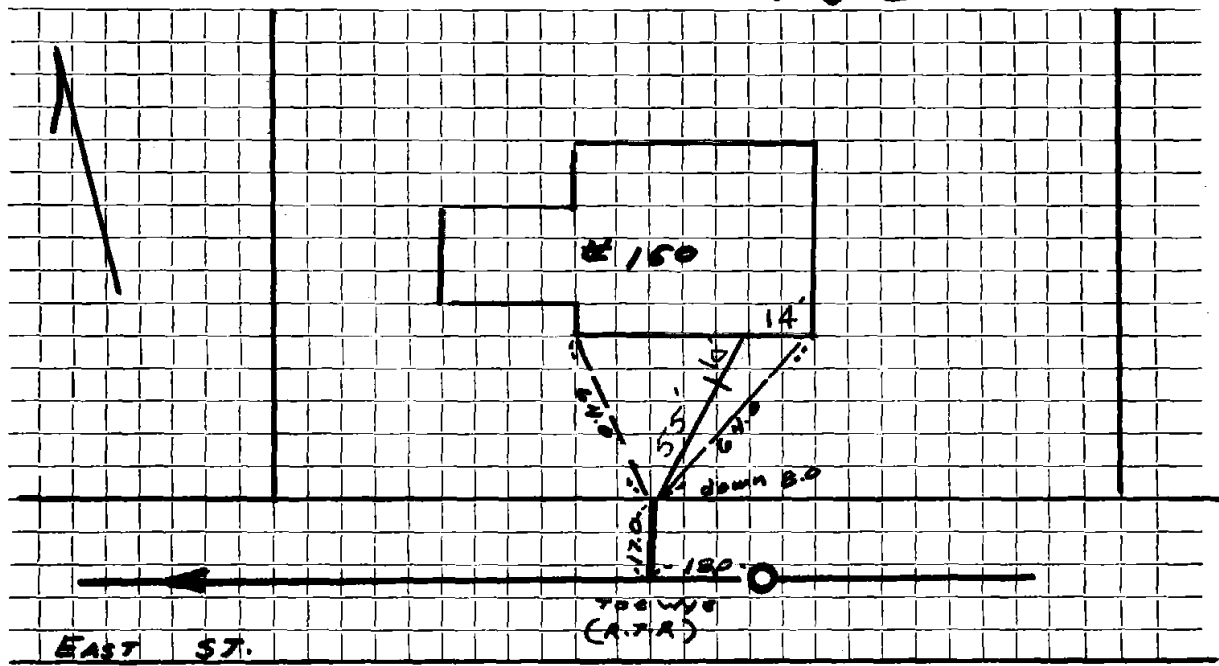

Connection made in Street. Work completed

Remarks:
.....
.....