

Name Jack Morrow

Service No. 47

Address #151 EAST ST.

Location

Kind of Pipe

Size

6" A.C.

Size of Main

8" A.C.

Repair—Renewal—New Service Kirkland Add Shaw #2514

Location

AUG 16 1976

Date	Material	Amount	Total	Date	Amount
11/9/72	250.00 @ 9.00	\$207.00		7-11-74	Deposit 207.00
10/7/74	40' 6" Transite Pipe				
	10' 4" Cast Iron Pipe				
				11-9-72	
				23' 6" A.C.	


DATE _____

TOWN OF LEXINGTON — BOARD OF PUBLIC WORKS

SEWER DIVISION

Sketch of Service Here

151

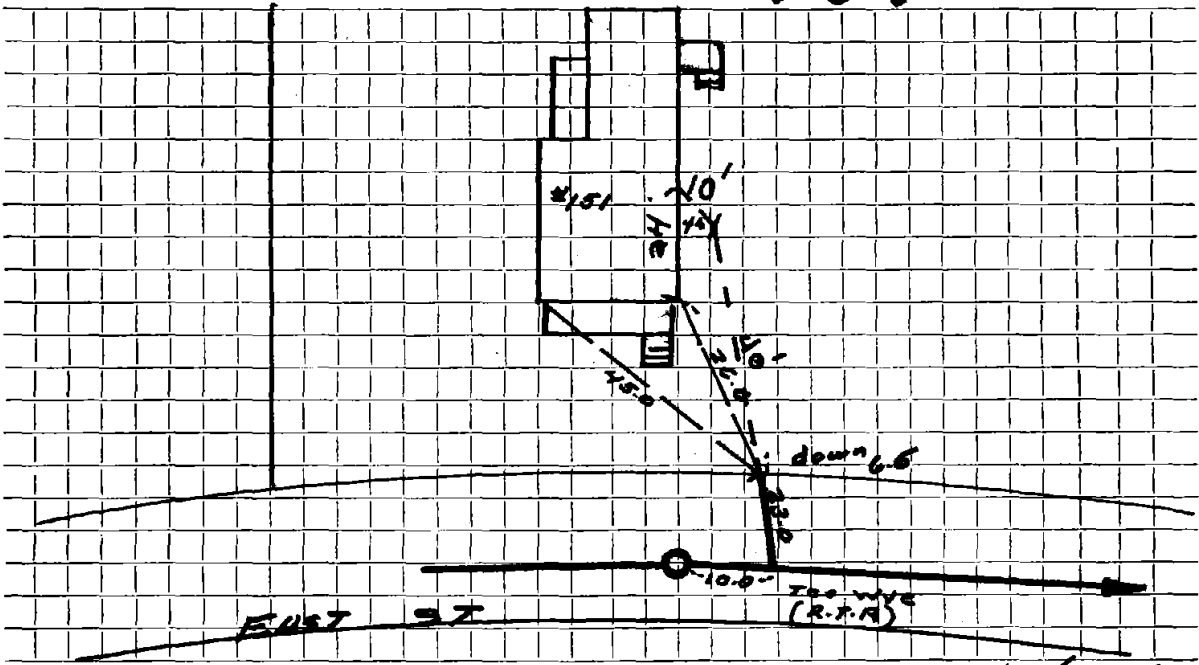

Connection made in #151 EAST ST Street.

Work completed 10/7/74

Remarks:

.....

.....