

Name

Service No.

Address #157 East St.

Location

Kind of Pipe

Size

6" A.C.

Size of Main

8" A.C.

Repair—Renewal—New Service

Location

Date

Material

Amount

Total

Date

Amount

~~11/9/72 260 A.C. @ 9.00 \$234.00~~

11-9-72
26' 6" A.C.


DATE _____

TOWN OF LEXINGTON — BOARD OF PUBLIC WORKS

SEWER DIVISION

Sketch of Service Here

157

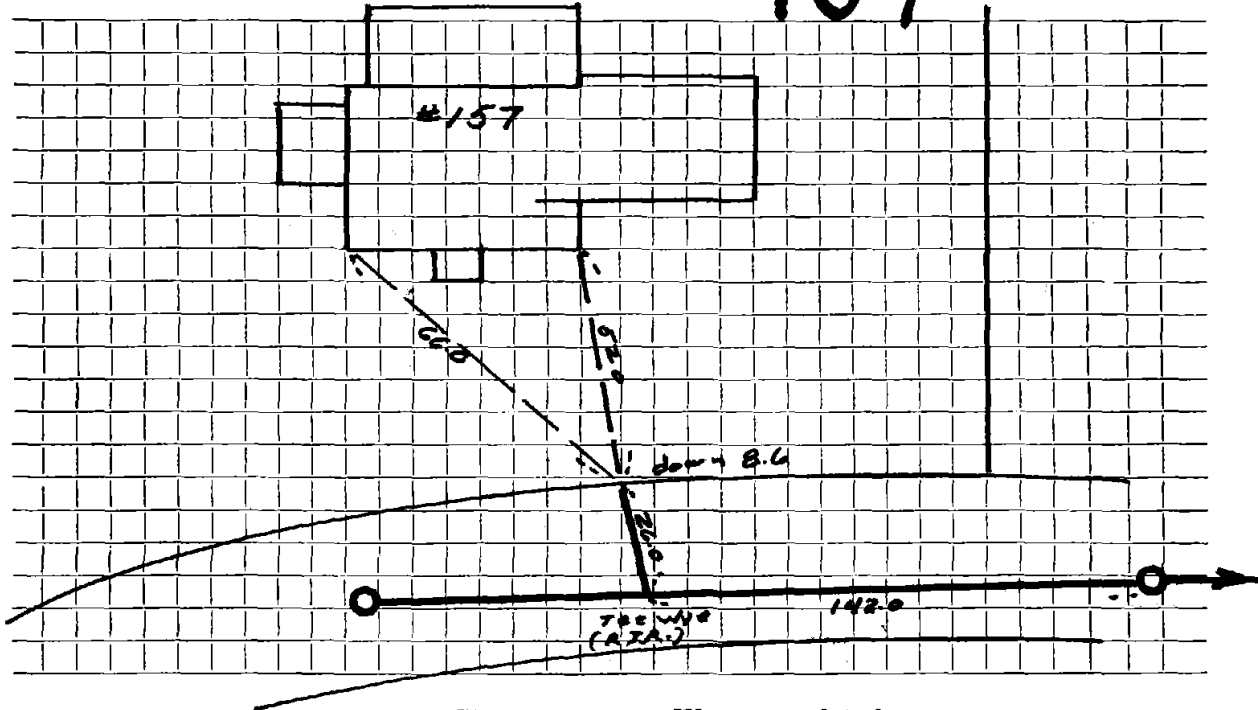

Connection made in Street. Work completed

Remarks:
.....
.....