

Name Robert E. Doran

Service No. 128

Address #168 EAST ST.

Location

Kind of Pipe

Size

6" A.C.

Size of Main 8" A.C.

Repair—Renewal—New Service Bonanno #2354

Location NOV 19 1973


Date	Material	Amount	Total	Date	Amount
11/10/72	310 A.C. @ 9.00	\$279.00		9-27-73	Deposit 279.00
10/13/73	12' 6" Transite pipe				
	6' 4" Cast Iron pipe				
				11-10-72	
				31' 6" A.C.	

DATE _____

TOWN OF LEXINGTON — BOARD OF PUBLIC WORKS

SEWER DIVISION

Sketch of Service Here **168**

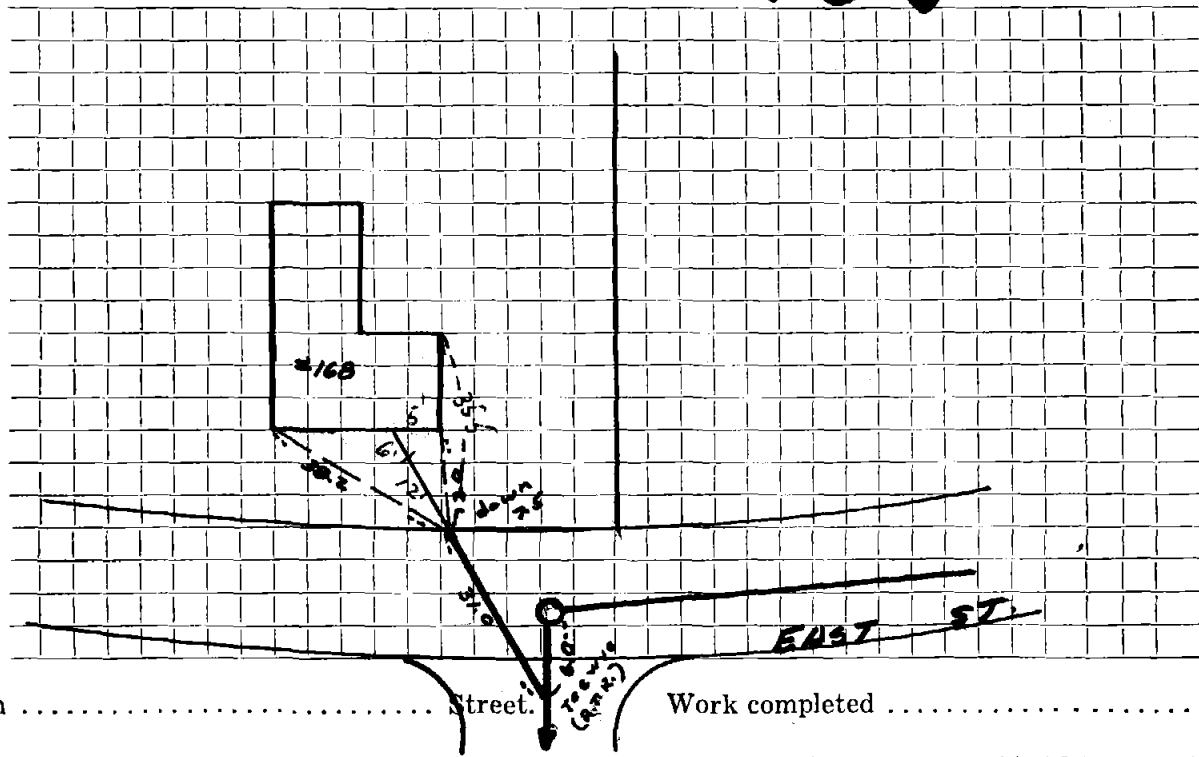

Connection made in Street. Work completed

Remarks:

.....

.....