

Name George Bailey

Service No. 129

Address #172 ~~f~~ = 174 EAST ST.

Location

Kind of Pipe

Size

6" A.C.

Size of Main 8" A.C.

Repair—Renewal—New Service Bonanno #2353

Location NOV 19 1973


Date	Material	Amount	Total	Date	Amount
11/10/72	16" A.C. @ \$9.00	\$144.00		9-29-73	Deposit 144.00
10/13/73	55' 6" Transite pipe				
	10' 4" Cast Iron pipe				
				11-10-72	
				16' 6" A.C.	

DATE _____

TOWN OF LEXINGTON — BOARD OF PUBLIC WORKS

SEWER DIVISION

Sketch of Service Here **172-174**

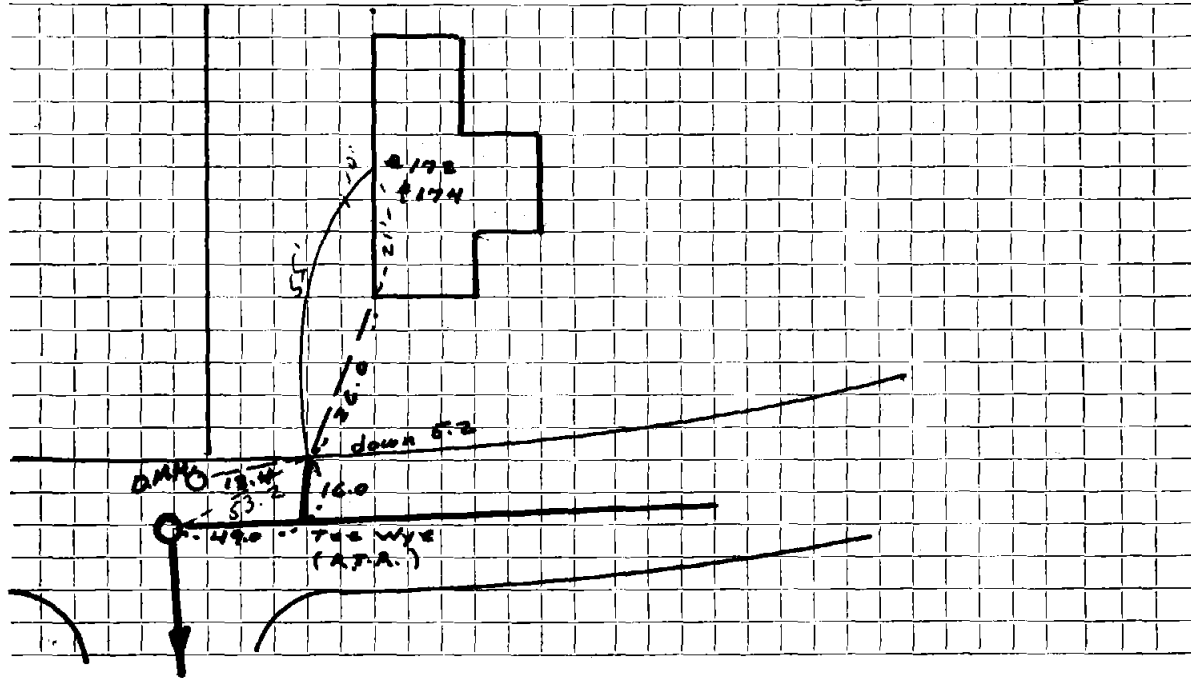

Connection made in Street. Work completed

Remarks:
.....
.....