

Name

Service No.

Address #178 EAST ST.

Location

Kind of Pipe

Size

6" A.C.

Size of Main

8" A.C.

Repair—Renewal—New Service

Location

Date

Material

Amount

Total

Date

Amount

~~4/10/72 220 AC @ 9.00 \$198.00~~

11-10-72


22' 6" A.C.

DATE _____

TOWN OF LEXINGTON — BOARD OF PUBLIC WORKS

SEWER DIVISION

Sketch of Service Here

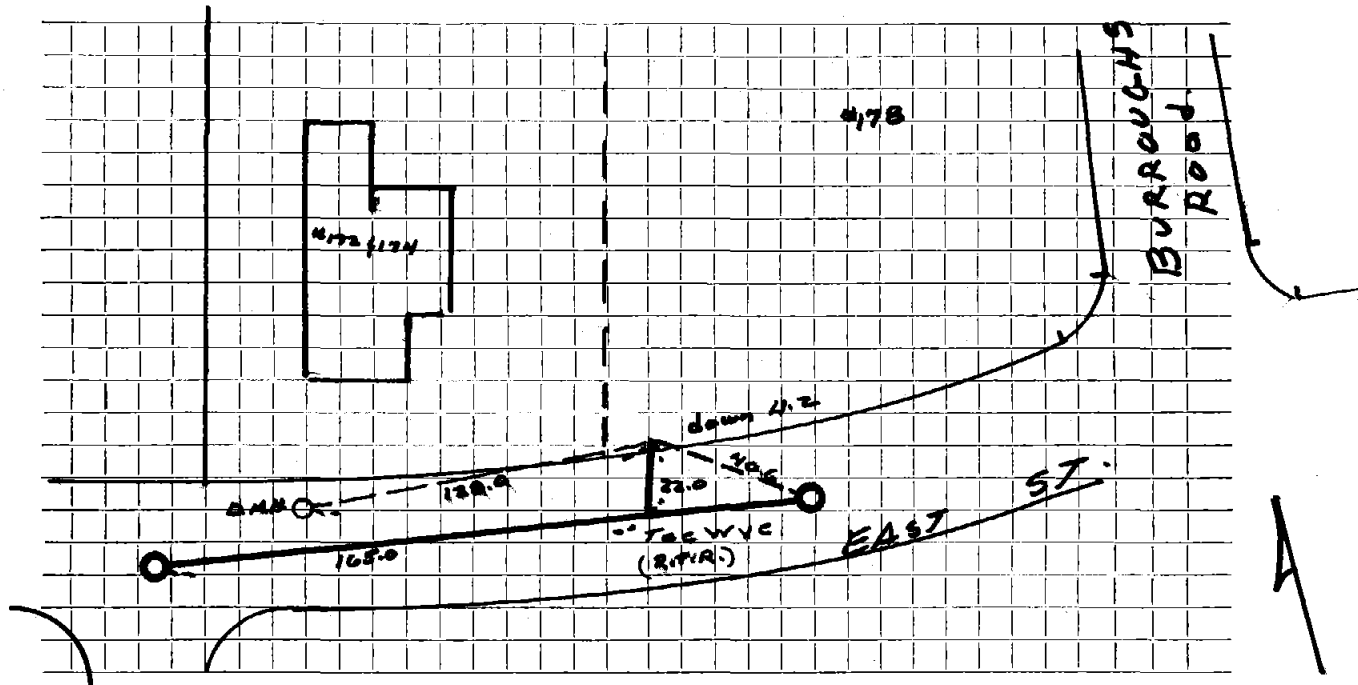

Connection made in Street. Work completed

Remarks:

.....
.....