

Name John E. Sykes

Service No. 14

Address #191 EAST ST.

Location

Kind of Pipe

Size

6" A.C.

Size of Main 8" A.C.

Repair—Renewal—New Service

Valeri Const Co.

2310

Location NOV 19 1973

Date

Material

Amount

Total

Date

Amount

12/15/72	13' @ \$9.00	\$117.00			3-31-73	Deposit	117.00
---------------------	-------------------------	---------------------	--	--	---------	---------	--------

9/11/73	38' 6" Transite pipe						
---------	----------------------	--	--	--	--	--	--

					12-13-72		
					13'	6" A.C.	


DATE _____

TOWN OF LEXINGTON — BOARD OF PUBLIC WORKS

SEWER DIVISION

Sketch of Service Here

191

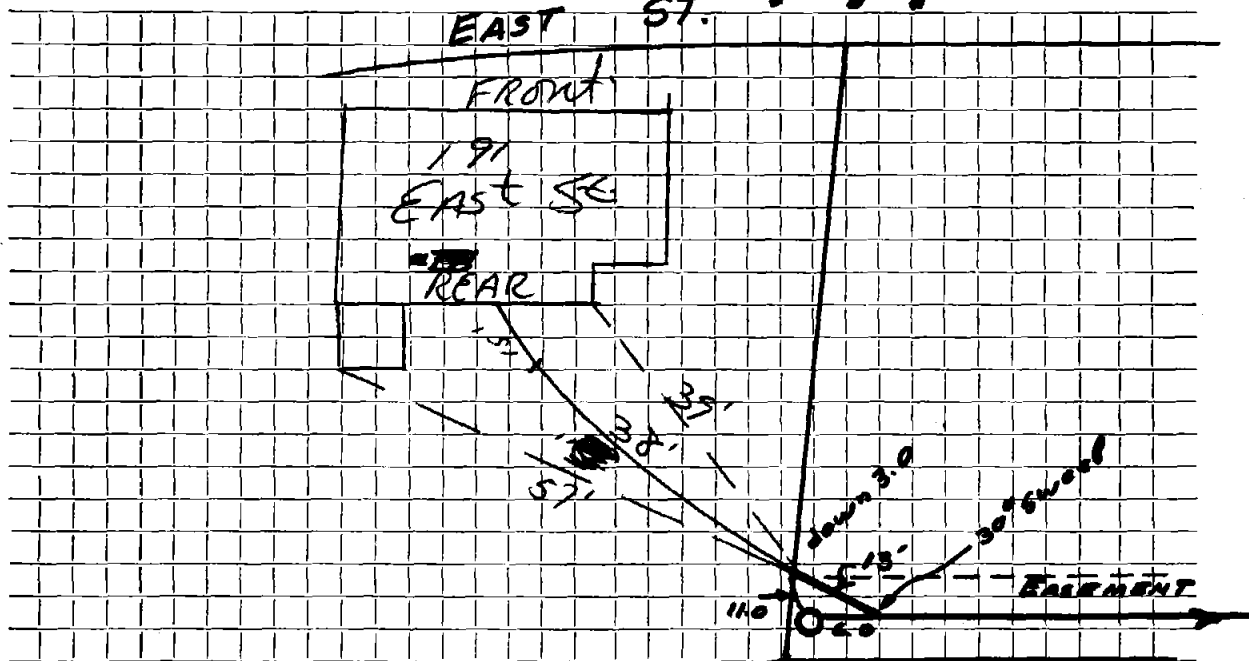

Connection made in Street. Work completed

Remarks:

.....
.....