

Name Ralph Braun

Service No.

Address #201 EAST ST.

Location

Kind of Pipe

Size

6" A.C.

Size of Main 8" A.C.

Repair—Renewal—New Service Valeri #2365

Location


Date	Material	Amount	Total	Date		Amount
<del>12/10/72</del>	N.C. (Easement)	—				
10/17/73	120' 6" Transite pipe					
	10' 4" Cast Iron pipe			12-13-72		
					11' 6" A.C.	

DATE \_\_\_\_\_

TOWN OF LEXINGTON — BOARD OF PUBLIC WORKS

SEWER DIVISION

Sketch of Service Here **201**

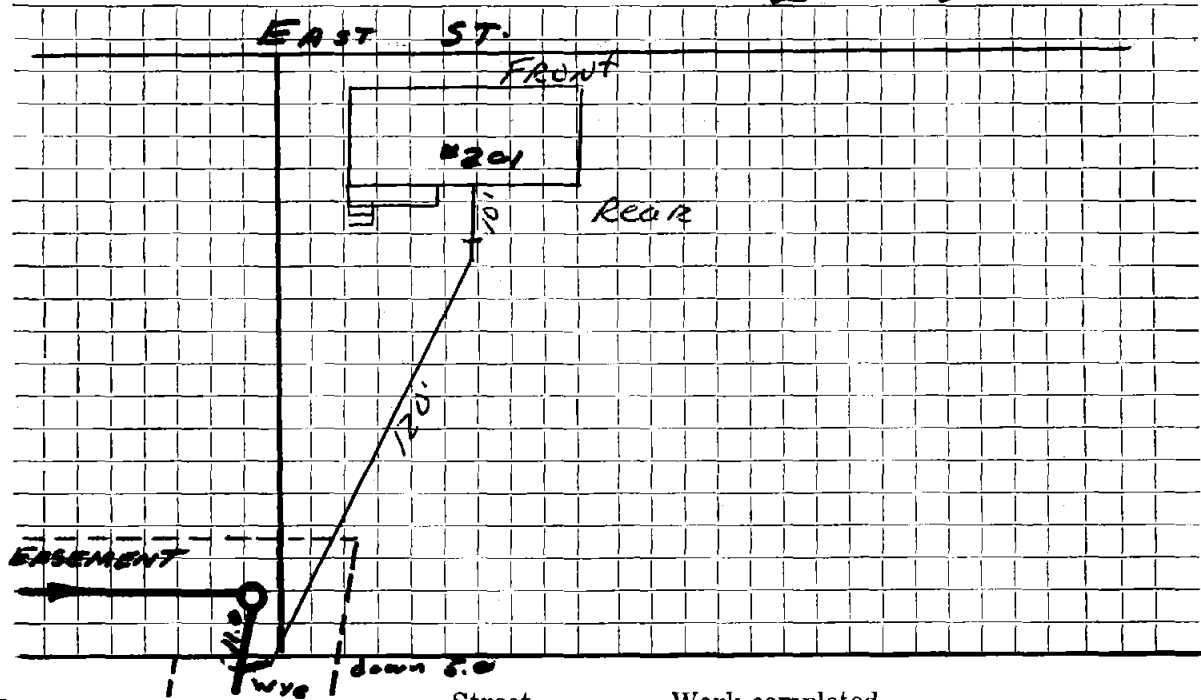

Connection made in ..... Street. Work completed .....

Remarks: .....

.....

.....