

Name James W. Bardsley

Service No. 141

Address #208 EAST ST.

Location

Kind of Pipe

Size 6" A.C.

Size of Main 8" A.C.

Repair—Renewal—New Service Valeri #2408

Location NOV 19 1973


Date	Material	Amount	Total	Date	Amount
11-16-72	16.0 A.C. @ 9.00	\$144.00		11-14-73	144.00
10/16/73	39' 6" Transite pipe				
	10' 4" Cast Iron pipe				
				11-16-72	
				16' 6" A.C.	

DATE _____

TOWN OF LEXINGTON — BOARD OF PUBLIC WORKS

SEWER DIVISION

Sketch of Service Here **208**

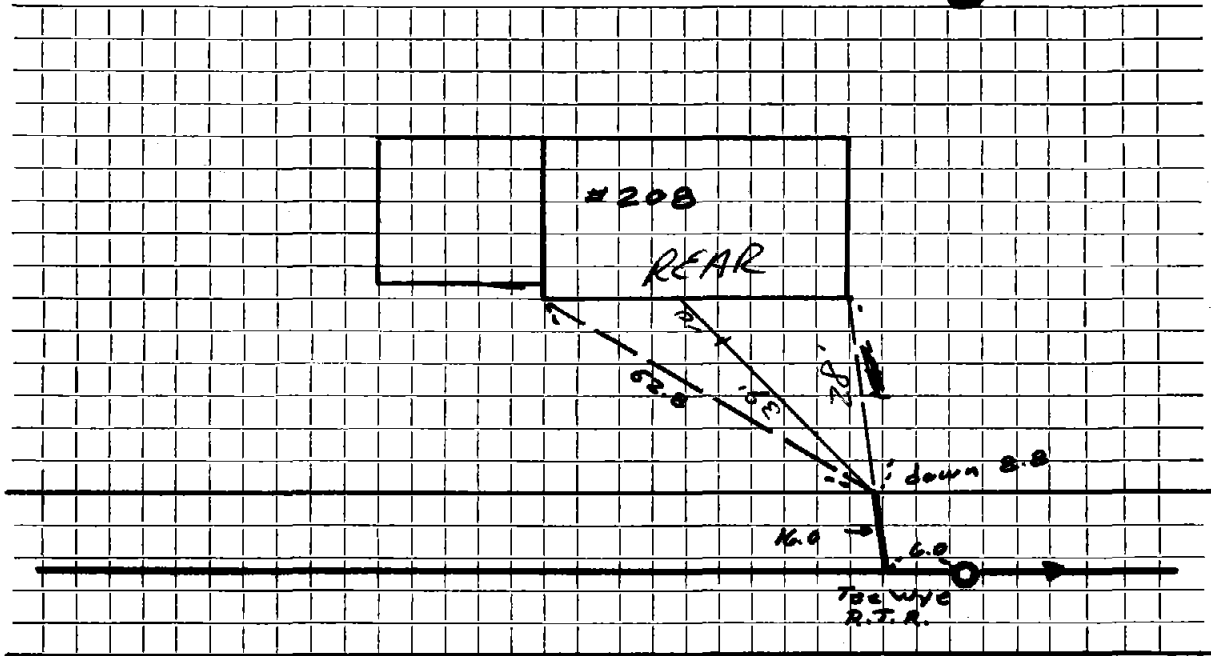

Connection made in Street. Work completed

Remarks:

.....
.....