

Name Melville F. Williams

Service No. 6

Address #212 EAST ST.

JUN 18 1973

Location

Kind of Pipe

Size

6" A.C.

Size of Main

8" A.C.

Repair—Renewal—New Service Valeri #2255

Location

Date	Material	Amount	Total	Date		Amount
4-16-72	170 A.C. @ 9.00	153.00		3-4-73	Deposit	153.00
3/14/73	13" 6" Transite pipe					
	10" 4" Cast Iron					
				11-16-72		
					17' 6" A.C.	


DATE _____

TOWN OF LEXINGTON — BOARD OF PUBLIC WORKS

SEWER DIVISION

Sketch of Service Here

213

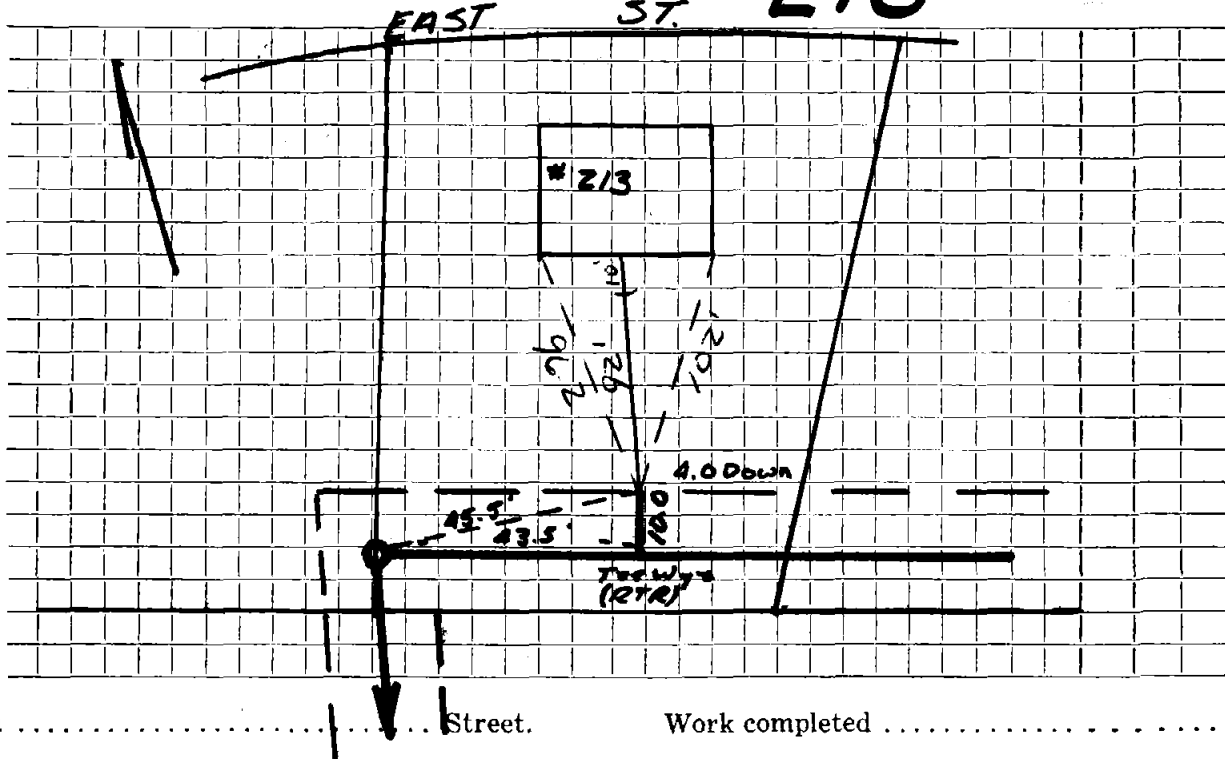

Connection made in Street. Work completed

Remarks:
.....
.....