

Name Joseph Sullivan

Service No. 38

Address #217 EAST ST

JUN 18 1973

Location

Kind of Pipe

Size

6" A.C.

Size of Main

8" A.C.

Repair—Renewal—New Service Valeri #2312


Location

Date	Material	Amount	Total	Date	Amount
4/30/72	10.0' 6" A.C. @ \$9.00	\$90.00		5-2-73	90.00
5/15/73	83' 6" Transite pipe				
	10' 4" Cast Iron pipe				
				11-20-72	
				10' 6" A.C.	

DATE _____

TOWN OF LEXINGTON — BOARD OF PUBLIC WORKS
SEWER DIVISION

Sketch of Service Here **217**

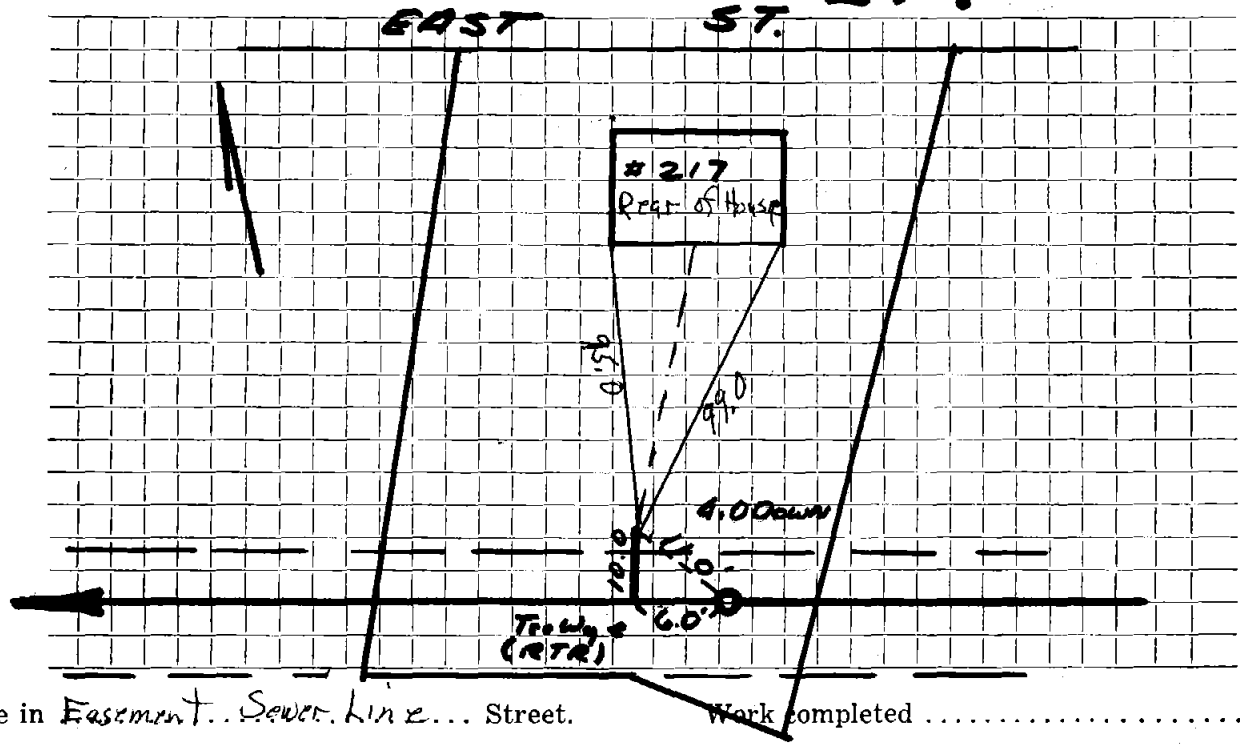

Connection made in Easement.. Sewer. line &... Street. Work completed

Remarks: