

Name Philip A. Fisher

Service No. 128

Address **#218 EAST ST**

Location

Kind of Pipe

Size

6" A.C.

Size of Main

8" A.C.

Repair—Renewal—New Service

Suburbanite Cesspool #2663

Location

AUG 16 1976


Date	Material	Amount	Total	Date	Amount	
11/16/72	16'-0" @ 9.00	144.00		11/22/74	Deposit	144.00
11/25/74	21' 6" Transite Pipe					
	10' 4" Cast Iron Pipe					
				11-16-72		
				16' 6" A.C.		

DATE _____

TOWN OF LEXINGTON — BOARD OF PUBLIC WORKS

SEWER DIVISION

Sketch of Service Here **218**

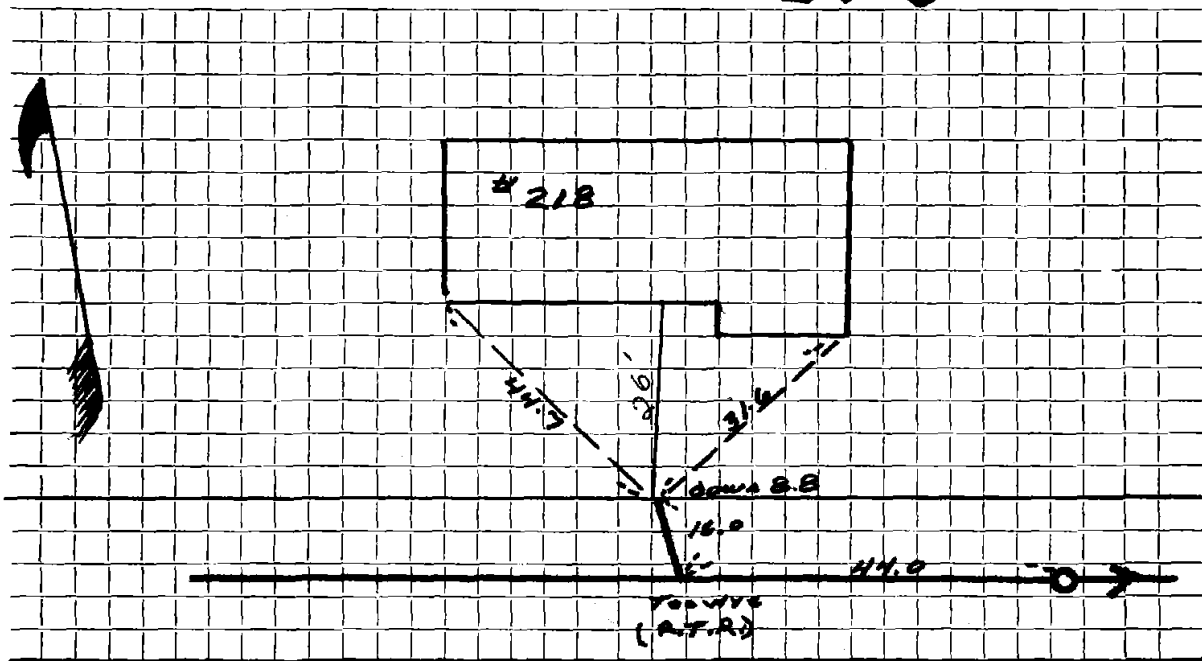

Connection made in 218 EAST ST. Street.

Work completed ~~11/25/74~~ 11/25/74

Remarks:

.....

.....