

Name Thomas Burke

Service No. 25

Address # 223 EAST ST

JUN 18 1973

Location

Kind of Pipe

Size

6" A.C.

Size of Main

8" A.C.

Repair—Renewal—New Service Valeri #2267

Location

Date	Material	Amount	Total	Date	Amount
<del>4/20/72</del>	<del>100' 6" A.C. @ 9.00</del>	<del>90.00</del>		4-9-73	Deposit
4/13/73	84' 6" Transite pipe				90.00
	5' 4" Cast Iron				
				11-20-72	
				10' 6" A.C.	


DATE \_\_\_\_\_

TOWN OF LEXINGTON — BOARD OF PUBLIC WORKS

SEWER DIVISION

Sketch of Service Here

EAST ST. 223

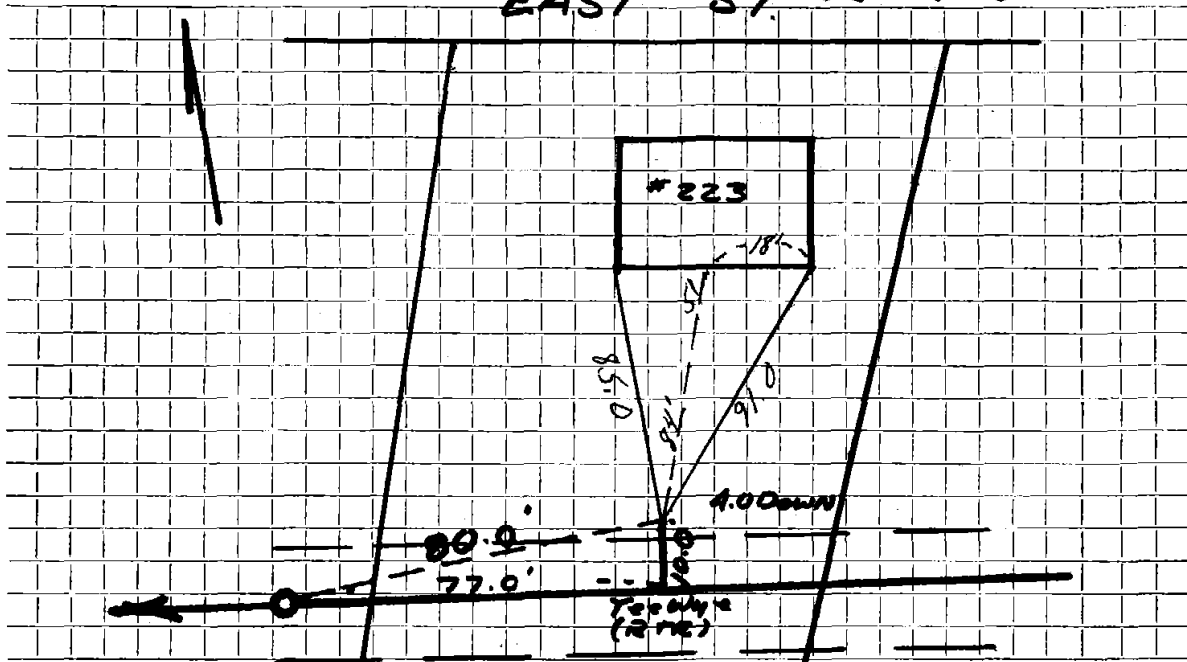

Connection made in ..... Street. Work completed .....

Remarks: .....  
.....  
.....