

Name James Ward

Service No. 5

Address #233 EAST ST.

Location

Kind of Pipe

Size 6" AC.

Size of Main 8" AC

Repair—Renewal—New Service

Craftsmen #2616

Location


AUG 1 1976

Date		Material	Amount		Total	Date		Amount	
11/20/72		30' 6" AC @ \$9.00	\$	27.00		3-12-75	Deposit		27.00
4/8/75	64'	6" Transite Pipe							
	14'	4" Cast Iron Pipe							
						11-20-72			
							3' 6" Transite		

DATE _____

TOWN OF LEXINGTON — BOARD OF PUBLIC WORKS

SEWER DIVISION

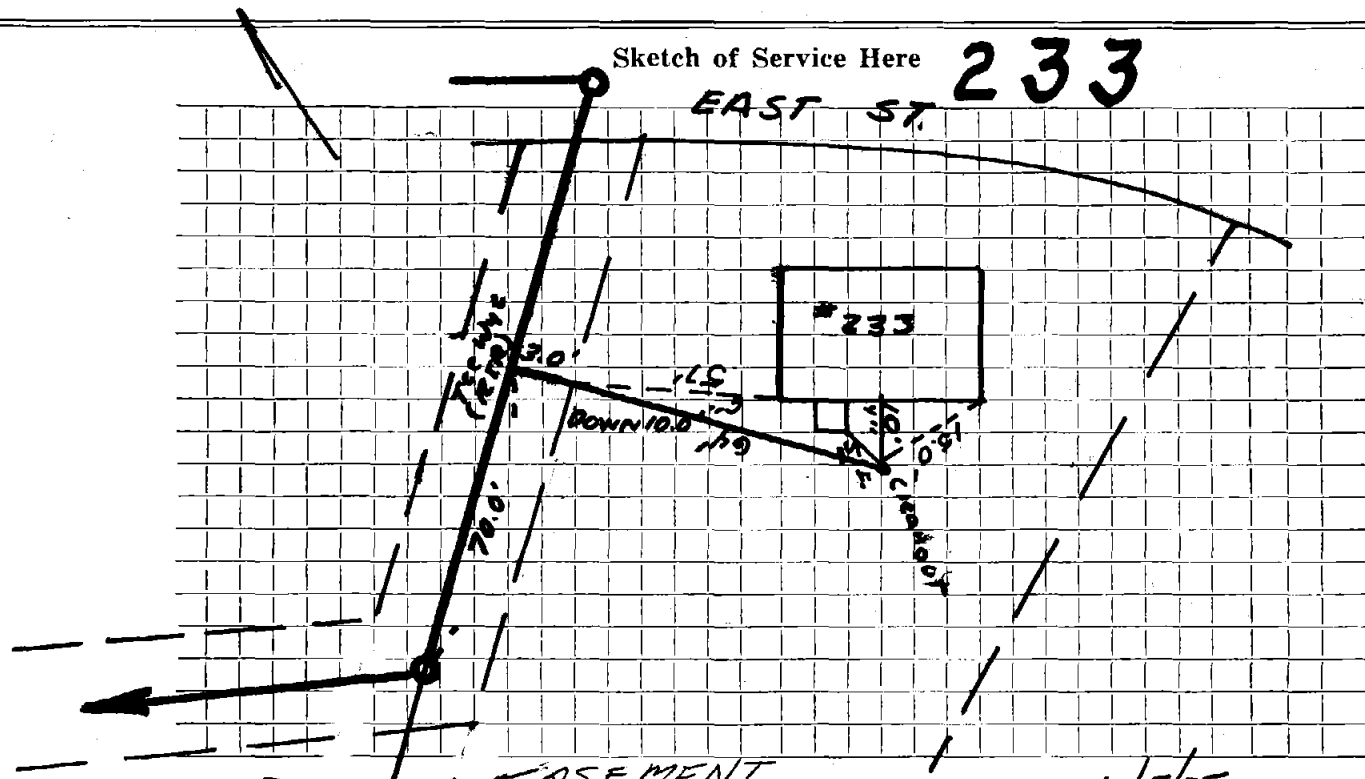

Connection made in ... 233 EAST ... Street. Work completed ... 4/8/75 ...

Remarks:

.....

.....