




DATE JUNE 10, 2013

TOWN OF LEXINGTON — BOARD OF PUBLIC WORKS

SEWER DIVISION

Sketch of Service Here

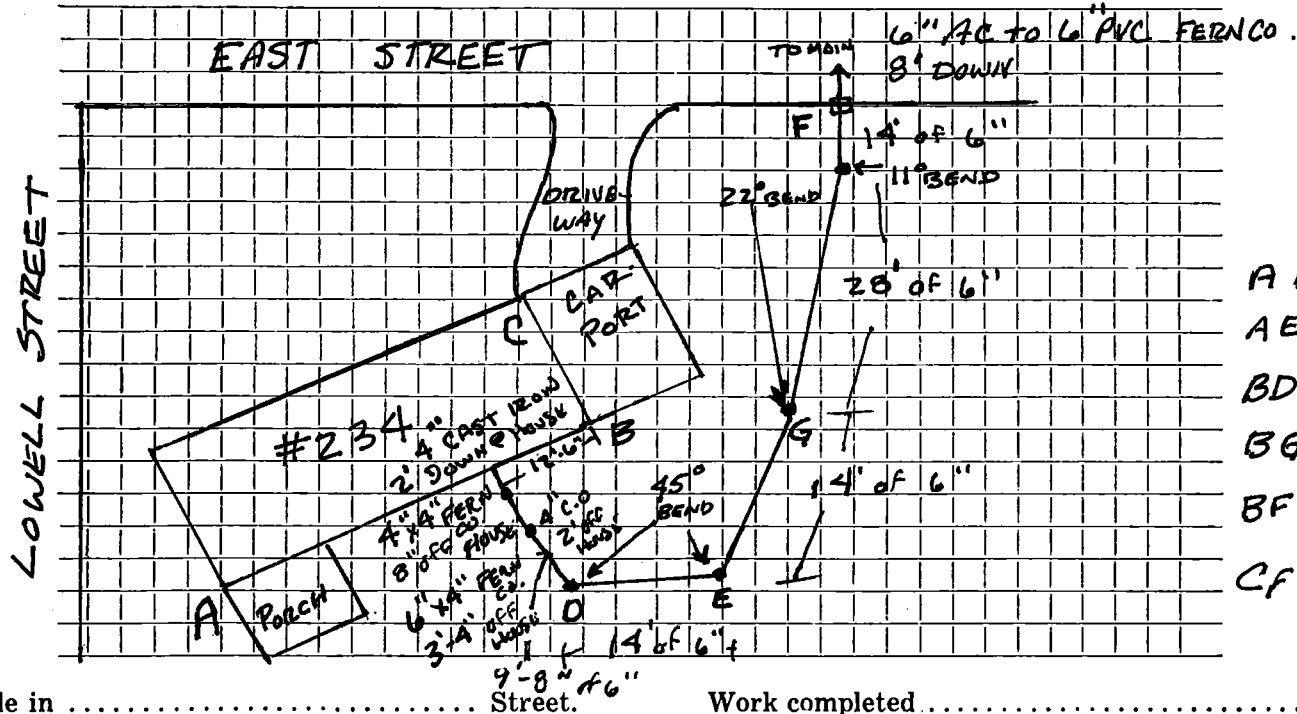

- AD = 33'-6"
- AE = 46'
- BD = 12'-8"
- BG = 13'-6"
- BF = 47'-3"
- CF = 46'-3"

Connection made in ..... Street. Work completed .....

Remarks: .....

- ..... POINT A - REAR RIGHT HOUSE CORNER - POINT C - FRONT LEFT HOUSE CORNER
- ..... POINT B - REAR LEFT HOUSE CORNER - POINT D - 45° BEND
- ..... POINT F - 6" PVC TO 6" AC CONNECTION - POINT E - 45° BEND - POINT G - 22° BEND