

Name

Service No.

Address 239 East Street

Lot 21

Location

Lot #

Kind of Pipe

Size

Size of Main

Repair—Renewal—New Service


Location

| Date | Material | Amount | Total | Date | Amount |
|--------------------|---------------------------------------|--------|------------------|-----------------|--------|
| Nov 170 | 13' 6" Transit pipe @ 7.50 | | 97.50 | | |
| | | | | 11--70 | |
| | | | | 13' 6" Transite | |
| | | | | | |
| | | | | | |
DATE _____

TOWN OF LEXINGTON — BOARD OF PUBLIC WORKS
SEWER DIVISION

Sketch of Service Here

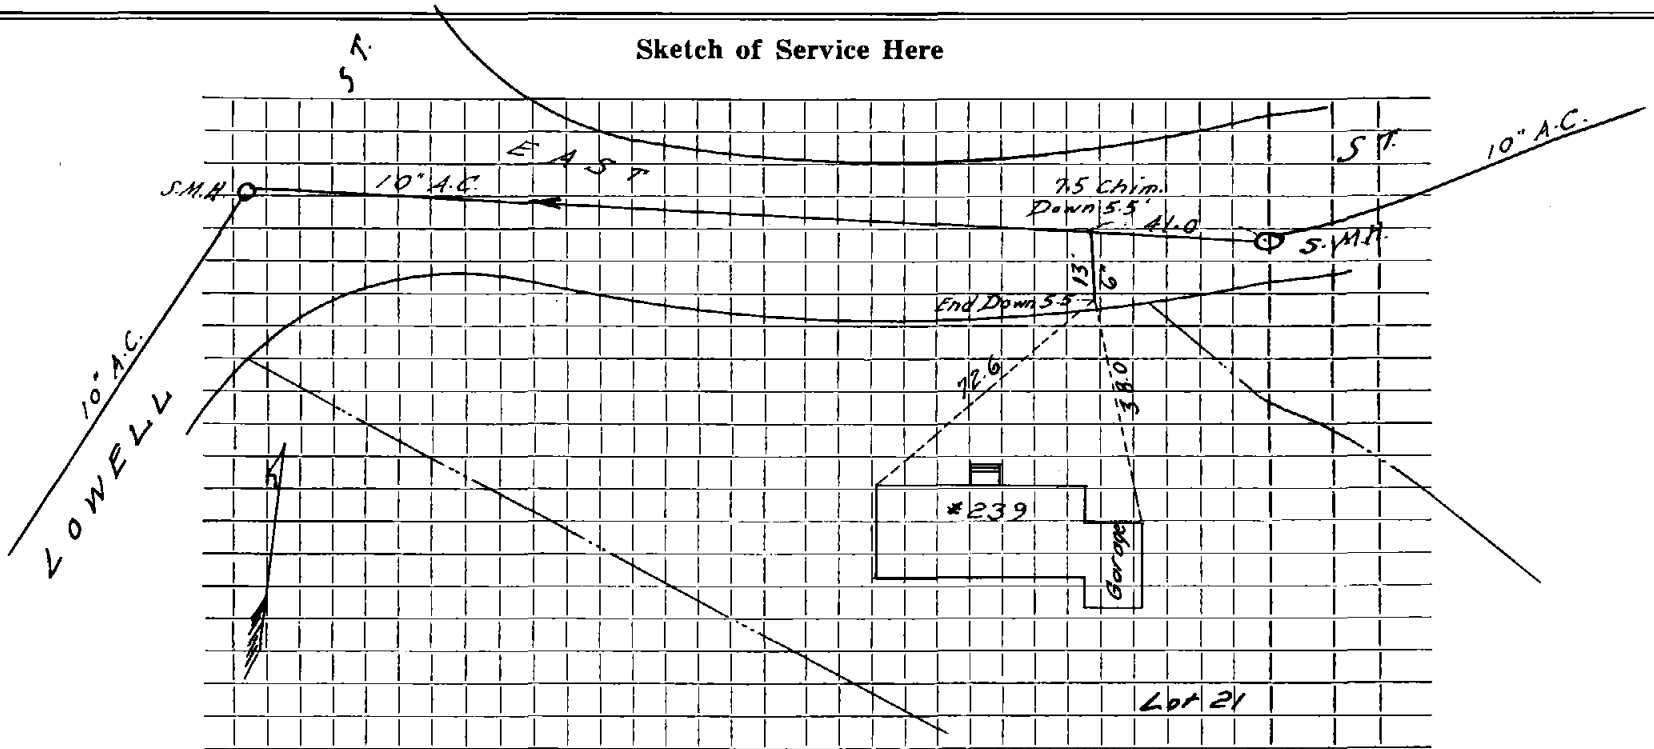

Connection made in Street. Work completed

Remarks:
.....
.....